

MISSISSIPPI DEPARTMENT OF NATURAL RESOURCES

Bureau of Land and Water Resources

Southport Mall

P.O. Box 10631

Jackson, Mississippi 39209

WATER WELL DRILLERS LOG

COASTAL DRILLING & SERVICE CO.

ROUTE 1 BOX 618

county well located

DIXON, MISS. 39532

HARRISON  
M 2322  
9-24-80  
9/24/80

date well completed 19

LANDOWNER: William Stron

description of formations encountered

from to

Rt 5 Cabot Lake Rd  
Bike Min Head 7  
(mailing address)

<u>Top Soil</u>	1	3
<u>Red Clay</u>	3	15
<u>Coarse white sand</u>	15	40
<u>S. Yellow Clay</u>	40	210
<u>Red Yellow Clay</u>	210	290
<u>fine white sand</u>	290	310
<u>Good Water Sand</u>	310	330

WELL LOCATION:

sec. 1 T. 2 N. R. 10 E. W  
Cabot Lake  
(distance) miles (direction) of (nearest town)

WELL PURPOSE: Home  
(home, irrigation, municipal, industrial)

WELL COMPLETION DATA:

- (1) diameter (inches) 2"
- (2) total depth (feet) 330'
- (3) static water level (feet) 40' below above top of ground.
- (4) casing PVC, 320'  
(material) (depth)  
(size) If telescope see back.
- (5) screen 10', 320'  
(length) (depth to top)  
2", PVC  
(size) (material)
- (6) pump One, 12  
(HP) (yield gpm)  
Electric  
(type power)
- (7) electric log no  
(yes or no)

(organization running log)

DEPT. OF NATURAL RESOURCES  
BUREAU OF LAND & WATER RESOURCES

(8) how well bottom plugged 2" back wash - 1/2" ball


JAN 12 1981

DRILLERS REMARKS: 19-B

RECEIVED

If well telescopes please sketch and show depths.

GROUND LEVEL

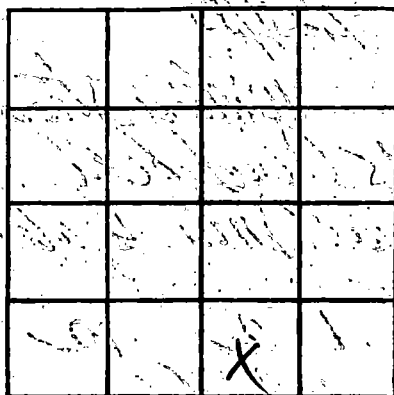

SECTION \_\_\_\_\_

Please indicate well location X.

ADDITIONAL INFORMATION

If more than one screen, show locations of each on sketch.