

MISSISSIPPI DEPARTMENT OF NATURAL RESOURCES

Bureau of Land and Water Resources

Southport Mall

P.O. Box 10631

Jackson, Mississippi 39209

WATER WELL DRILLERS LOG  
COASTAL DRILLING & SERVICE CO.

ROUTE 1 BOX 618 *Harrison*  
BILOXI, MISS. 39532  
county well located

HARRISON  
M 2326  
11-18-80  
11/18/80

19 80  
date well completed

LANDOWNER: C.M. Co.

Flagship Rd

Hgt. Miss  
(mailing address)

WELL LOCATION:

sec 29 T 8 N R 10 E  
S W

1/4 North Mississippi City  
(distance) mil of (direction) of (nearest town)

WELL PURPOSE:

(home, irrigation, municipal, industrial) Metal

WELL COMPLETION DATA:

(1) diameter (inches) 4 1/2"

(2) total depth (feet) 505'

(3) static water level (feet) 600' below top of ground.

(4) casing PVC 490'  
(material) (depth)

4 1/2" If telescope see back.  
(size)

(5) screen 15' 490'  
(length) (depth to top)

2" PVC  
(size) (material)

(6) pump 1 1/2 25  
(HP) (yield gpm)

Ele  
(type power)

(7) electric log no  
(yes or no)

(organization running log)

(8) how well bottom plugged 2" pack with valve

description of formations encountered	from	to
<u>top soil</u>	<u>1</u>	<u>3</u>
<u>Super Sand</u>	<u>3</u>	<u>40</u>
<u>Coarse white sand</u>	<u>40</u>	<u>110</u>
<u>Super Sand</u>	<u>110</u>	<u>160</u>
<u>SP Blue Clay</u>	<u>160</u>	<u>310</u>
<u>fine white sand</u>	<u>310</u>	<u>360</u>
<u>hard Blue Clay</u>	<u>360</u>	<u>460</u>
<u>fine white sand</u>	<u>460</u>	<u>480</u>
<u>Coarse white sand</u>	<u>480</u>	<u>505</u>

DEPT. OF NATURAL RESOURCES  
BUREAU OF LAND & WATER RESOURCES

MAY 28 1981


RECEIVED

DRILLERS REMARKS:

If well telescopes please sketch and show depths.

GROUND LEVEL

200' 4" PVC Casing

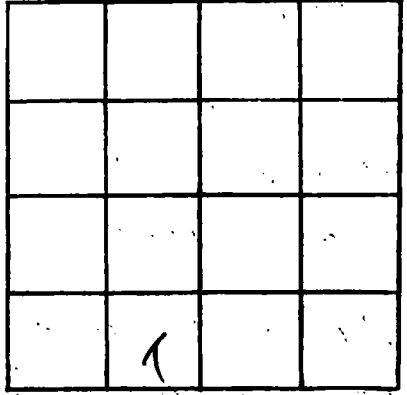

SECTION \_\_\_\_\_

Please indicate well location X.

ADDITIONAL INFORMATION

290' 2" PVC Casing

15' 2" PVC Screen

2" back wash valve  
19-B

If more than one screen, show locations of each on sketch.