

MISSISSIPPI DEPARTMENT OF NATURAL RESOURCES

Bureau of Land and Water Resources

Southport Mall

P.O. Box 10631

Jackson, Mississippi 39209

WATER WELL DRILLERS LOG
COASTAL DRILLING & SERVICE CO.

ROUTE 1 BOX 618

Harrison
county well located

BILOXI, MISS. 39532

HARRISON
M 2328

12/16/80
12/16/80
date well completed

LAND OWNERS: *Truck Co.*

E-10 Woodman & Ef

Bilat's Smis
(mailing address)

WELL LOCATION:

sec. *3* T. *7* N. R. *10* E
(2) 1/2 miles East of *Colville*
(distance) (direction) (nearest town)

WELL PURPOSE: *Truck Sales*
(home, irrigation, municipal, industrial)

WELL COMPLETION DATA:

- (1) diameter (inches) *4 1/2"*
- (2) total depth (feet) *325'*
- (3) static water level (feet) *35* below above top of ground.
- (4) casing *PVC* *310'*
(material) (depth)
4 1/2" if telescope see back.
(size)
- (5) screen *15'* *310'*
(length) (depth to top)
2" *PVC*
(size) (material)
- (6) pump *one* *20*
(HP) (yield gpm)
Elc
(type power)
- (7) electric log *no*
(yes or no)

(organization running log)

(8) how well bottom plugged
2" lead wash down

DRILLERS REMARKS:

description of formations encountered

description of formations encountered	from	to
<i>top soil</i>	<i>1</i>	<i>3</i>
<i>red clay</i>	<i>3</i>	<i>18</i>
<i>blue white sand</i>	<i>18</i>	<i>40</i>
<i>soft blue clay</i>	<i>40</i>	<i>210</i>
<i>fine white sand</i>	<i>210</i>	<i>230</i>
<i>hard blue clay</i>	<i>230</i>	<i>290</i>
<i>fine white sand</i>	<i>290</i>	<i>310</i>
<i>good white sand</i>	<i>310</i>	<i>325</i>

DEPT. OF NATURAL RESOURCES
BUREAU OF LAND & WATER RESOURCES

MAY 28 1981

RECEIVED

If well telescopes please sketch and show depths.


GROUND LEVEL

160' 4" PDC Casing

150' 2" PDC Casing

15' 2" PDC Casing

2" back wash Valve

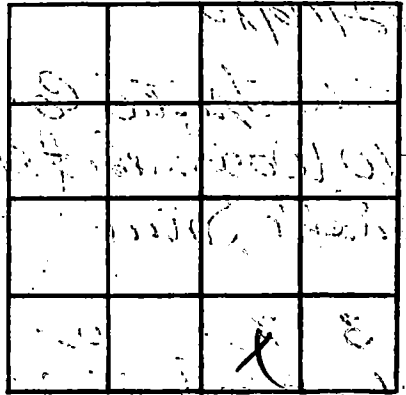

SECTION

Please indicate well location X.

ADDITIONAL INFORMATION

Handwritten notes in the additional information section include:

- 1250
- 125
- 108 114
- 108 21
- 108 115
- 108 110
- 108
- 108 115

If more than one screen, show locations of each on sketch.