

MISSISSIPPI DEPARTMENT OF NATURAL RESOURCES

Bureau of Land and Water Resources

Southport Mall

P.O. Box 10631

Jackson, Mississippi 39209

COASTAL WATER WELL DRILLERS LOG

ROUTE 1 BOX 618

BILOXI, MISS. firm name

county well located

Hanson  
M  
2330

date well completed 19 1/25/81

Hanson

LANDOWNER

Shadeleaf Johnson Steel Pond  
Biloxi Min  
(mailing address)

description of formations encountered

from to

<u>top soil</u>	<u>1</u>	<u>3</u>
<u>red clay</u>	<u>3</u>	<u>10</u>
<u>gray sand</u>	<u>10</u>	<u>21</u>
<u>red clay</u>	<u>21</u>	<u>35</u>
<u>blue white sand</u>	<u>35</u>	<u>50</u>
<u>soft blue clay</u>	<u>50</u>	<u>220</u>
<u>hard blue clay</u>	<u>220</u>	<u>310</u>
<u>fine water sand</u>	<u>310</u>	<u>310</u>
<u>coarse water sand</u>	<u>310</u>	<u>335</u>

WELL LOCATION:

sec. 4 T. 7 N. R. 9 E  
Cypress Creek  
(distance) miles (direction) of (nearest town)

WELL PURPOSE:

(home, irrigation, municipal, industrial) home

WELL COMPLETION DATA:

- (1) diameter (inches) 4 1/2"
- (2) total depth (feet) 335'
- (3) static water level (feet) 20' below top of ground
- (4) casing PVC 320'  
(material) (depth)
- 4 1/2"  
(size) if telescope see back.
- (5) screen 15' 320'  
(length) (depth to top)
- 2" PVC  
(size) (material)
- (6) pump 1/2 HP 20  
(HP) (yield gpm)
- Ele  
(type power)
- (7) electric log no  
(yes or no)

(organization running log)

(8) no well bottom plugged

Seal  
DRILLERS REMARKS

DEPT. OF NATURAL RESOURCES  
BUREAU OF LAND & WATER RESOURCES


MAR 2 1982

RECEIVED

If well telescopes please sketch and show depths.

GROUND LEVEL

160' 4" PVC  
Casing

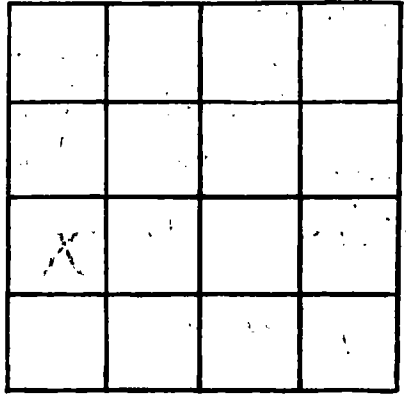

SECTION \_\_\_\_\_

Please indicate well location X.

ADDITIONAL INFORMATION

160' 2" PVC  
Casing

15' 2" PVC Screen

2" Jack Wash Valve  
Sand Seal

If more than one screen,  
show locations of each on sketch.