

MISSISSIPPI DEPARTMENT OF NATURAL RESOURCES

Bureau of Land and Water Resources

Southport Mall

P.O. Box 10631

Jackson, Mississippi 39209

WATER WELL DRILLERS LOG

HARRISON
M 2335
3/3/81
March 3

date well completed

1981 Duncan Well Drilling Harrison
firm name county well located

LANDOWNER: Johnny Moore

description of formations encountered

from

to

Hay Road

Biloxi, Ms.

(mailing address)

WELL LOCATION:

sec. 5 T 7 N R 9 E
4 miles N.W of Dyersville
(distance) (direction) (nearest town)

<u>Top Sand</u>	<u>0</u>	<u>40</u>
<u>Clay</u>	<u>40</u>	<u>85</u>
<u>Blue Clay</u>	<u>85</u>	<u>272</u>
<u>Green Sand</u>	<u>272</u>	<u>304</u>
<u>Course Sand</u>	<u>304</u>	<u>346</u>

WELL PURPOSE: Home
(home, irrigation, municipal, industrial)

WELL COMPLETION DATA:

(1) diameter (Inches) 2"
(2) total depth (feet) 346 ft.
(3) static water level (feet) _____ below
top of ground above

(4) casing pvc 336'
(material) (depth)
(size) If telescope see back.

(5) screen 10' 336'
(length) (depth to top)
2" pvc
(size) (material)

(6) pump _____ (HP) _____ (yield gpm)
(type power)

(7) electric log _____ (yes or no)
(organization running log)


(8) how well bottom plugged Sand

DRILLERS REMARKS: Owner had his own pump

RECEIVED
MAY 16 1981

If well telescopes please sketch and show depths.

GROUND LEVEL

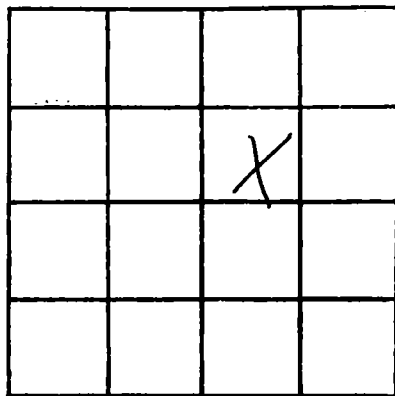

SECTION 5

Please indicate well location X.

ADDITIONAL INFORMATION

If more than one screen, show locations of each on sketch.