

MISSISSIPPI DEPARTMENT OF NATURAL RESOURCES

Bureau of Land and Water Resources

Southport Mall

P.O. Box 10631

Jackson, Mississippi 39209

WATER WELL DRILLERS LOG

COASTAL DRILLING & SERVICE CO.

ROUTE 1 BOX 618 *Harrison*

firm name

county well located

BILOXI, MISS. 39532

Harrison
M 2336
3-5-81

3/5/81 19
 date well completed

LANDOWNER

description of formations encountered

from

to

John C. Coley
Yellow Lake Road

top soil

1

3

Billy J. Davis
 (mailing address)

Red Clay

3

16

WELL LOCATION:

Coarse white sand

16

40

sec. 12 T. 7 N. R. 10 E.

bed

40

45

None ^S miles *South* ^W of *Yellow Lake* (nearest town)

Soft sand

45

60

WELL PURPOSE:

Soft Blue Clay

60

210

(home, irrigation, municipal, industrial)

fine water sand

210

295

WELL COMPLETION DATA:

Soft Blue Clay

235

310

(1) diameter (inches) 2"

hard Blue Clay

310

410

(2) total depth (feet) 465'

fine water sand

440

465

(3) static water level (feet) 40' below top of ground

Coarse white sand

440

465

(4) casing PK 455' (material) (depth)

(size) if telescope see back.

(5) screen 10' 455' (length) (depth to top)

2" PK (size) (material)

(6) pump 1/2 12 (HP) (yield gpm)


44 (type power)

(7) electric log no (yes or no)

(organization running log)

(8) how well bottom plugged 2' bed of water

DRILLERS REMARKS: 19-B

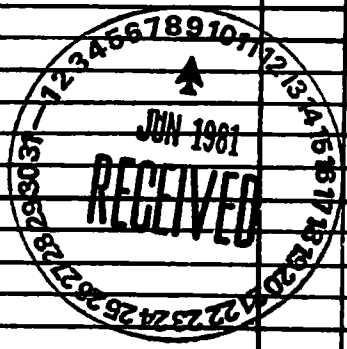

If well telescopes please sketch and show depths.

GROUND LEVEL

	X		

SECTION _____

Please indicate well location X.

ADDITIONAL INFORMATION



If more than one screen, show locations of each on sketch.