

HARRISON
 M 2340
 3/7/81
 3-7-81

MISSISSIPPI
 BOARD OF WATER COMMISSIONERS
 416 North State Street
 Jackson, Mississippi 39201

WATER WELL DRILLERS LOG
 BRADEN PUMP AND WELL SERVICE, INC. HARRISON
 date well completed firm name county well located

LANDOWNER:
 S.L. FAYARD
 1006 Holley St.
 Biloxi, MS
 (mailing address)

WELL LOCATION:
 sec 33 T 7 N R 9 E
 10 miles Biloxi
 (distance) (direction) (nearest town)

WELL PURPOSE: HOME
 (home, irrigation, municipal, industrial)

WELL COMPLETION DATA:
 (1) diameter (inches) 4 1/2
 (2) total depth (feet) 640'
 (3) static water level (feet) 70 below top of ground.
 (4) casing PVC, total (depth) 641
 4 1/2 (size) if telescope see back.
 (5) screen 10' (length), 16 10' (depth to top)
 2" (size), PVC underbar (material)
 (6) pump 1 (HP), 15 (yield gpm)
 230 (type power)
 (7) electric log No (yes or no)
 (organization running log)

(8) how well bottom plugged
 8" sand shark

DRILLERS REMARKS:
 20' tail pipe

description of formations encountered	from	to
SAND	30	50
CLAY	50	70
SAND	70	100
CLAY	100	130
SAND	130	160
CLAY	160	190
SAND	190	220
CLAY	220	250
SAND	250	280
CLAY	280	310
SAND	310	340
CLAY	340	370
SAND	370	400
CLAY	400	430
SAND	430	460
CLAY	460	490
SAND	490	520
CLAY	520	550
SAND	550	580
CLAY	580	610
SAND	610	640

DEPT. OF NATURAL RESOURCES
 BUREAU OF LAND & WATER RESOURCES

MAY 10 1981

RECEIVED

If well telescopes please sketch and show depths.

GROUND LEVEL

4" sch 40 PVC

4 x 2 bushing
PVC

200'

2" sch 40 PVC


2" PVC underbore
screen

610'

620'

2" B.W valve

640'

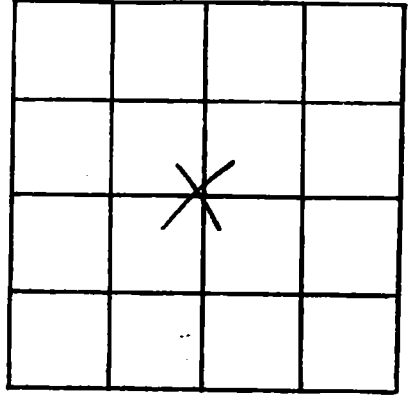

SECTION 33

Please indicate well location X.

ADDITIONAL INFORMATION

If more than one screen,
show locations of each on sketch.