

Harrison
M 2345
5-28-81

MISSISSIPPI
BOARD OF WATER COMMISSIONERS 6
416 North State Street
Jackson, Mississippi 39201

WATER WELL DRILLERS LOG,
BRADEN PUMP AND WELL SERVICE, INC.

S-28-81
date well completed

ROUTE 1, BOX 489

HARRISON
county well located

SAUCIER, MS #39574


LANDOWNER:
Tommy KENNEDY
Motsie Rd
Biloxi, MS 39532
(mailing address)

description of formations encountered	from	to
CLAY	0	70
SAND	70	85
CLAY	85	100

WELL LOCATION:
sec. B T 7 N 10 E
3 miles N of Biloxi
(distance) (direction) (nearest town)

WELL PURPOSE: HOME
(home, irrigation, municipal, industrial)


- WELL COMPLETION DATA:
- (1) diameter (inches) 2"
 - (2) total depth (feet) 100'
 - (3) static water level (feet) 20 below top of ground.
 - (4) casing PVC, TOTAL,
(material) (depth)
2" if telescope see back.
(size)
 - (5) screen 10, 75
(length) (depth to top)
2", PVC underbar
(size) (material)
 - (6) pump 1, 2 1/2
(HP) (yield gpm)
220
(type power)
 - (7) electric log NO
(yes or no)
 - (organization running log)
 - (8) how well bottom plugged
2" sand shark

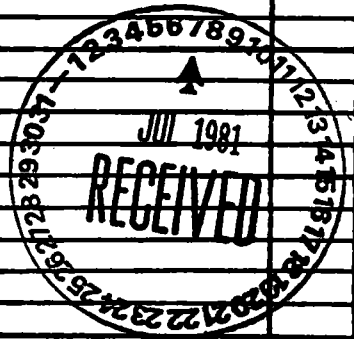

DRILLERS REMARKS:
15' tail pipe

If well telescopes please sketch and show depths.

GROUND LEVEL

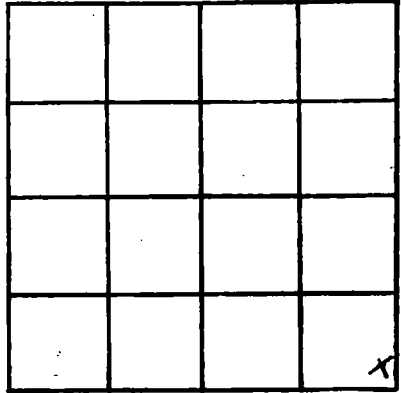

SECTION 13

Please indicate well location X.

ADDITIONAL INFORMATION

If more than one screen, show locations of each on sketch.