

MISSISSIPPI DEPARTMENT OF NATURAL RESOURCES

Bureau of Land and Water Resources

Southport Mall

P.O. Box 10631

Jackson, Mississippi 39209

COASTAL WATER WELL DRILLERS LOG
 WATER WELL DRILLING & SERVICE CO.

ROUTE 1 BOX 618

BILOXI, MISS. film name 38532

county well located

Harrison
M
2348

7/22/81
 date well completed

Harrison
 county well located

LANDOWNER: H B Jone
 Rt 1 Box 685
 Biloxi Min
 (mailing address)

WELL LOCATION:
 sec. S 7 N R. 10 E
Coahuila
 (distance) (direction) (nearest town)

WELL PURPOSE: home
 (home, irrigation, municipal, industrial)

WELL COMPLETION DATA:

- (1) diameter (inches) 2"
- (2) total depth (feet) 528'
- (3) static water level (feet) 50' below above top of ground.
- (4) casing pvc, 518', (depth)
 (size) if telescope see back.
- (5) screen 10', 518' (length) (depth to top)
2", pvc (size) (material)
- (6) pump oneal 12 (HP) (yield gpm)
Elle (type power)
- (7) electric log no (yes or no)
 (organization running log)

(8) how well bottom plugged
Industrial - drilled
 DRILLERS REMARKS: Seal

description of formations encountered	from	to
<u>Top Soil</u>	<u>1</u>	<u>3</u>
<u>Red Clay</u>	<u>3</u>	<u>18</u>
<u>Super Sand</u>	<u>18</u>	<u>40</u>
<u>Soft Blue Clay</u>	<u>40</u>	<u>210</u>
<u>fine water sand</u>	<u>210</u>	<u>260</u>
<u>Soft Blue Clay</u>	<u>260</u>	<u>340</u>
<u>hard Blue Clay</u>	<u>340</u>	<u>460</u>
<u>fine water sand</u>	<u>460</u>	<u>510</u>
<u>good water sand</u>	<u>510</u>	<u>528</u>


DEPT. OF NATURAL RESOURCES
 BUREAU OF LAND & WATER RESOURCES

FEB 15 1982

RECEIVED

If well telescopes please sketch and show depths.

GROUND LEVEL

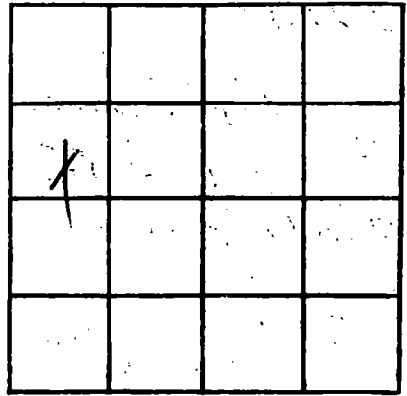

SECTION _____

Please indicate well location X.

ADDITIONAL INFORMATION

If more than one screen,
show locations of each on sketch.