

MISSISSIPPI DEPARTMENT OF NATURAL RESOURCES

Bureau of Land and Water Resources

Southport Mall

P.O. Box 10631

Jackson, Mississippi 39209

COASTAL WATER WELL DRILLERS LOG

ROUTE 1 BOX 618

BILOXI, MISS firm name 39532

*Harrison*  
county well located

*Harrison*  
*M*  
*2349*

*7/25/81* 19  
date well completed

LANDOWNER: *George Lee*

description of formations encountered

from to

*Rt 1 Box 614 B*

<i>top soil</i>	<i>1</i>	<i>3</i>
<i>Red Clay</i>	<i>3</i>	<i>15</i>
<i>gray sand</i>	<i>15</i>	<i>30</i>
<i>Soft Blue Clay</i>	<i>30</i>	<i>160</i>
<i>hard blue clay</i>	<i>160</i>	<i>230</i>
<i>good water sand</i>	<i>230</i>	<i>260</i>

*Bilali, Miss*  
(mailing address)

WELL LOCATION:

sec. *3* T. *7* N R. *10* E  
*None* miles *East* of *Woolmire*  
(distance) (direction) (nearest town)

WELL PURPOSE: *home*  
(home, irrigation, municipal, industrial)

WELL COMPLETION DATA:

- (1) diameter (inches) *4 1/2"*
- (2) total depth (feet) *260'*
- (3) static water level (feet) *35'* below top of ground.
- (4) casing *px* *250'*  
(material) (depth)  
*4 1/2"* If telescope see back.  
(size)
- (5) screen *10'* *250'*  
(length) (depth to top)  
*2"* *px*  
(size) (material)
- (6) pump *Wahlmill*  
(HP) (yield gpm)  
*Wendmill*  
(type power)
- (7) electric log *no*  
(yes or no)

(organization running log)

DEPT. OF NATURAL RESOURCES  
BUREAU OF LAND & WATER RESOURCES


JAN 15 1982

RECEIVED

(8) how well bottom plugged  
*2 ft back with valve*  
DRILLERS REMARKS: *1975*

If well telescopes please sketch and show depths.

GROUND LEVEL

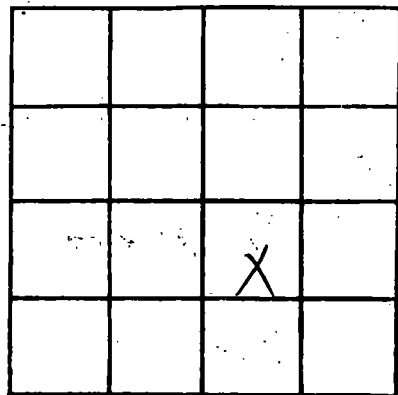

SECTION \_\_\_\_\_

Please indicate well location X.

ADDITIONAL INFORMATION

Lined area for additional information.

If more than one screen, show locations of each on sketch.