

MISSISSIPPI DEPARTMENT OF NATURAL RESOURCES

Bureau of Land and Water Resources

Southport Mall

P.O. Box 10631

Jackson, Mississippi 39209

WATER WELL DRILLERS LOG  
COASTAL DRILLING & SERVICE CO.

ROUTE 1 BOX 618  
film name

*Harrison*  
county well located

BILOXI, MISS. 39532

HARRISON  
M 2350  
7/25/81

7/25/81 19  
date well completed

LANDOWNER: Walking Horse  
P.O. Box 1146  
Bellevue, Miss  
(mailing address)

description of formations encountered	from	to
top soil	1	3
Red Clay hard	3	18
gray sand	18	40
(color) white sand	40	60
stiff blue clay	60	215
hard blue clay	215	280
fine water sand	280	290
good water sand	290	315

WELL LOCATION:  
sec. 6 T 7 N R 9 E  
Celanese  
S W  
(distance) miles (direction) of (nearest town)

WELL PURPOSE: none  
(home, irrigation, municipal, industrial)

WELL COMPLETION DATA:

(1) diameter (inches) 4 1/2"

(2) total depth (feet) 315'

(3) static water level (feet) 35' below above top of ground.


(4) casing PVC, 300'  
(material) (depth)  
4 1/2" If telescope see back.  
(size)

(5) screen 15', 300'  
(length) (depth to top)  
2", PVC  
(size) (material)

(6) pump None, 20  
(HP) (yield gpm)  
5hp  
(type power)

(7) electric log no  
(yes or no)

(organization running log)

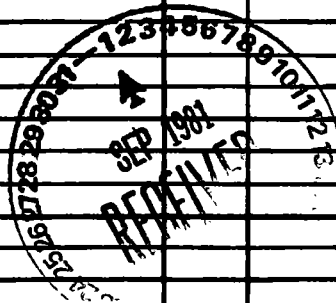

(8) has well bottom plugged  
2 good water  
DRILLERS REMARKS: 19-B

If well telescopes please sketch and show depths.

GROUND LEVEL

160' 4" *pd* Casing

140' 2" *pd* Casing

15' 2" *pd* Screen

2" *lock* Wash Valve

	X		

SECTION \_\_\_\_\_

Please indicate well location X.

ADDITIONAL INFORMATION

If more than one screen, show locations of each on sketch.