

MISSISSIPPI DEPARTMENT OF NATURAL RESOURCES

Bureau of Land and Water Resources

Southport Mall

P.O. Box 10631

Jackson, Mississippi 39209

COASTAL WATER WELL DRILLERS LOG

ROUTE 1 BOX 618

BILOXI, MISS. firm name 39532

Harrison
county well located

Harrison
M
2351

8/11/81 19
date well completed

LANDOWNER *Jack Fulton*
Rt 1 Box 707
Lat Miss
(mailing address)

description of formations encountered	from	to
<i>Top Soil</i>	<i>1</i>	<i>3</i>
<i>Red Clay</i>	<i>3</i>	<i>20</i>
<i>Green Sand</i>	<i>20</i>	<i>40</i>
<i>Coarse white Sand</i>	<i>40</i>	<i>110</i>
<i>Soft Blue Clay</i>	<i>110</i>	<i>315</i>
<i>fine water Sand</i>	<i>315</i>	<i>330</i>
<i>hard blue Clay</i>	<i>330</i>	<i>460</i>
<i>fine water Sand</i>	<i>460</i>	<i>470</i>
<i>good water Sand</i>	<i>470</i>	<i>500</i>

WELL LOCATION:
sec. *7* T. *7* N. R. *10* E
Fruit Creek
(distance) *1* miles (direction) *W* of (nearest town)

WELL PURPOSE: *home*
(home, irrigation, municipal, industrial)

- WELL COMPLETION DATA:
- (1) diameter (inches) *2"*
 - (2) total depth (feet) *500'*
 - (3) static water level (feet) *60'* below top of ground
 - (4) casing *PVC*, *490'*
(material), (depth)
(size) if telescope see back.
 - (5) screen *10'*, *490'*
(length), (depth to top)
2", *PVC*
(size), (material)
 - (6) pump *1/2*, *10 gpm*
(HP), (yield gpm)
ell
(type power)
 - (7) electric log *no*
(yes or no)
(organization running log)

DEPT. OF NATURAL RESOURCES
BUREAU OF LAND & WATER RESOURCES


JAN 15 1982

RECEIVED

(8) how well bottom plugged
2" Sand Seal
DRILLERS REMARKS

If well telescopes please sketch and show depths.

GROUND LEVEL

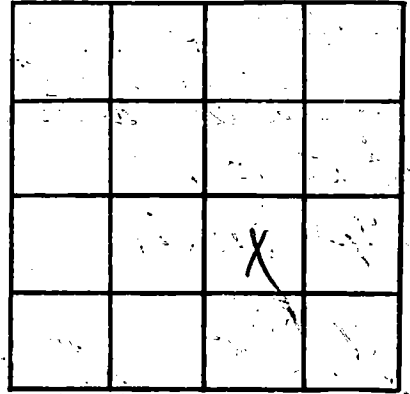

SECTION _____

Please indicate well location X.

ADDITIONAL INFORMATION

If more than one screen,
show locations of each on sketch.