

MISSISSIPPI DEPARTMENT OF NATURAL RESOURCES

Bureau of Land and Water Resources

Southport Mall

P.O. Box 10631

Jackson, Mississippi 39209

WATER WELL DRILLERS LOG

COASTAL DRILLING & SERVICE CO.

ROUTE # 1 BOX 618

county well located

HARRISON
M 2352
8/25/81

date well completed

LANDOWNER

et 5

Pilot's Inn
(mailing address)

WELL LOCATION:

sec. 5 T. 7 N. R. 9 E.
S. W.
Lehman's Pines
(distance) miles (direction) of (nearest town)

WELL PURPOSE:

(home, irrigation, municipal, industrial) home

WELL COMPLETION DATA:

- (1) diameter (inches) 2"
- (2) total depth (feet) 300'
- (3) static water level (feet) 40' below above top of ground.
- (4) casing PVC, 290', (material), (depth)
(size) If telescope see back.
- (5) screen 10', 290', (length), (depth to top)
2", PVC, (size), (material)
- (6) pump One 1/2, 12, (HP), (yield gpm)
3/4, (type power)
- (7) electric log no, (yes or no)
(organization running log)


(8) how well bottom plugged

2' fresh water value
DRILLERS REMARKS: 19-B

BILOXI, MISS. 39532


description of formations encountered

	from	to
top soil	1	3
red clay	3	10
yellow sand	10	25
white river sand	25	60
coarse white sand	60	110
soft blue clay	110	200
hard blue clay	200	265
soft water sand	265	300

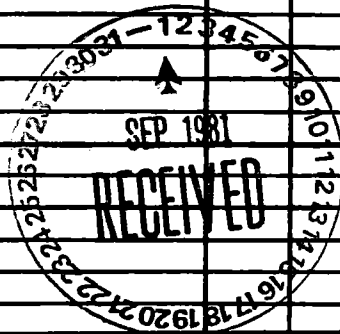

If well telescopes please sketch and show depths.

GROUND LEVEL

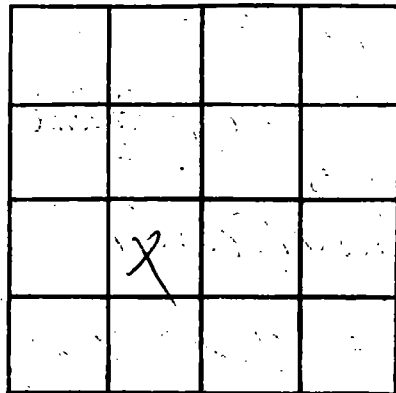

SECTION _____

Please indicate well location X.

ADDITIONAL INFORMATION

Multiple horizontal lines for writing additional information.

If more than one screen, show locations of each on sketch.