

MISSISSIPPI DEPARTMENT OF NATURAL RESOURCES

Bureau of Land and Water Resources

Southport Mall

P.O. Box 10631

Jackson, Mississippi 39209

COASTAL DRILLING & SERVICE CO. WATER WELL DRILLERS LOG

ROUTE 1 BOX 618

BILOXI, MISS. 39532

Hamilton county well located

Hamilton
M
2354

10/1/81
date well completed

LANDOWNER

Leo Lee

description of formations encountered

from

to

WELL LOCATION:

sec 3 T 7 N R 0 E

Washwood (distance) miles (direction) (nearest town)

WELL PURPOSE: home (home, irrigation, municipal, industrial)

WELL COMPLETION DATA:

- (1) diameter (inches) 2"
- (2) total depth (feet) 365'
- (3) static water level (feet) 50' below top of ground.
- (4) casing PVC 355' (material) (depth)
- (size) If telescope see back.
- (5) screen 10' 355' (length) (depth to top)
- 2" PVC (size) (material)
- (6) pump 1/2 HP 10 gpm (HP) (yield gpm)
- 1/2 (type power)
- (7) electric log no (yes or no)

(organization running log)

(8) how well bottom plugged

2" back wash seal
DRILLERS REMARKS: Sand Seal

description of formations encountered	from	to
top soil	1	3
Red Clay	3	15
white sand	15	40
Soft Blue Clay	40	160
fine water sand	160	175
hard blue clay	175	300
fine water sand	300	340
good water sand	340	365


DEPT. OF NATURAL RESOURCES
BUREAU OF LAND & WATER RESOURCES

JAN 21 1982

RECEIVED

If well telescopes please sketch and show depths.

GROUND LEVEL

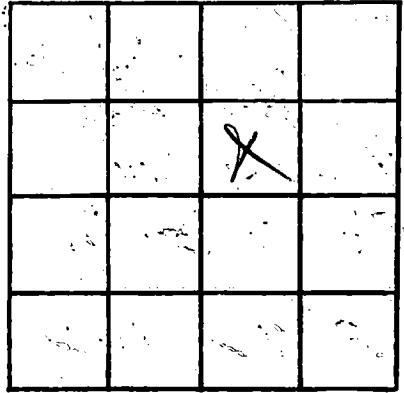

SECTION _____

Please indicate well location X.

ADDITIONAL INFORMATION

If more than one screen, show locations of each on sketch.