

MISSISSIPPI DEPARTMENT OF NATURAL RESOURCES

Bureau of Land and Water Resources

Southport Mall

P.O. Box 10631

Jackson, Mississippi 39209

COASTAL DRILLING & SERVICE CO. WATER WELL DRILLERS LOG

ROUTE 1 BOX 618

BILOXI, MISS. 39532 firm name

Hamison county well located

Hamison
M
2350

10/1/81 date well completed

LANDOWNER: Tester (Carter)
Comp Road (Folger)
Biloxi, Miss
(mailing address)

description of formations encountered	from	to
top soil	1	3
red clay	3	10
gray soil	10	25
soft blue clay	25	120
fine water sand	120	135
soft blue clay	135	210
hard blue clay	210	225
good water sand	225	240

WELL LOCATION:
sec. 18 T 7 N R. 9 E
Magnolia Bend
(distance) (direction) (nearest town)

WELL PURPOSE: home
(home, irrigation, municipal, industrial)

WELL COMPLETION DATA:

(1) diameter (inches) 2"

(2) total depth (feet) 240'

(3) static water level (feet) 10' below top of ground.

(4) casing st 230'
(material) (depth)

2" if telescope see back.
(size)

(5) screen 10' 230'
(length) (depth to top)

2" pl
(size) (material)

(6) pump 1/2 hp 15
(HP) (yield gpm)

ele
(type power)

(7) electric log no
(yes or no)

(organization running log)

DEPT. OF NATURAL RESOURCES
BUREAU OF LAND & WATER RESOURCES


FEB 15 1982

RECEIVED

(8) how well bottom plugged
good seal
DRILLERS REMARKS

If well telescopes please sketch and show depths.

GROUND LEVEL

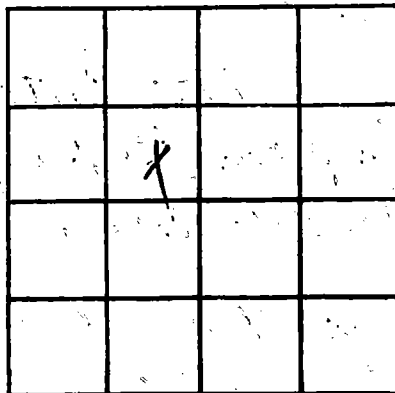

SECTION _____

Please indicate well location X.

ADDITIONAL INFORMATION

If more than one screen, show locations of each on sketch.