

MISSISSIPPI DEPARTMENT OF NATURAL RESOURCES

Bureau of Land and Water Resources

Southport Mall

P.O. Box 10631

Jackson, Mississippi 39209

COASTAL DRILLING & SERVICE CO. WATER WELL DRILLERS LOG

ROUTE 1 BOX 618

BILOXI, MISS. 39532

county well located

Hanson
M
2356

10/1/81
date well completed

Hanson

LANDOWNER: Hampstead Wood
Biloxi River Camp
apt. 101
(mailing address)

description of formations encountered	from	to
top soil	1	3
red clay	3	10
(blue-white sand)	10	25
gray sand	25	40
light blue clay	40	180
hard blue clay	180	270
fine white sand	270	280
good water sand	280	300

WELL LOCATION:
sec. S 7 N R. 10 E
Coahuila
(distance) (direction) of (nearest town)

WELL PURPOSE: line stand
(home, irrigation, municipal, industrial)

WELL COMPLETION DATA:

(1) diameter (inches) 24

(2) total depth (feet) 300'

(3) static water level (feet) 5' below top of ground.

(4) casing PVC (material), 290' (depth),
(size) If telescope see back.

(5) screen 10' (length), 290' (depth to top),
2" (size), PVC (material)

(6) pump 1 1/2 HP (HP), 15 (yield gpm),
ELC (type power)

(7) electric log no (yes or no)
(organization running log)

(8) how well bottom plugged
24 inch water seal
DRILLERS REMARKS: Sand seal


DEPT. OF NATURAL RESOURCES
BUREAU OF LAND & WATER RESOURCES

FEB 15 1982

RECEIVED

If well telescopes please sketch and show depths.

GROUND LEVEL

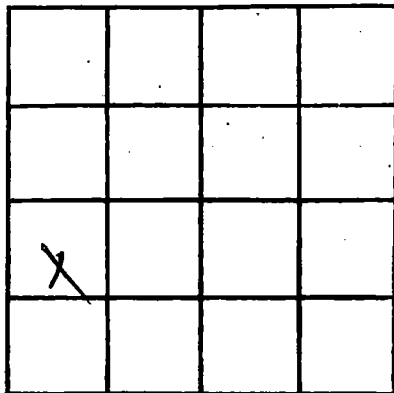

SECTION _____

Please indicate well location X.

ADDITIONAL INFORMATION

If more than one screen, show locations of each on sketch.