

MISSISSIPPI DEPARTMENT OF NATURAL RESOURCES

Bureau of Land and Water Resources

Southport Mall

P.O. Box 10631

Jackson, Mississippi 39209

WATER WELL DRILLERS LOG

Harrison
M
2360

11/12/81 19 1981 Lyman Well Co. Harrison
 date well completed firm name county well located

LANDOWNER: Joe Spooner
Rt 9 Box 1269
Apt, Ind
 (mailing address)

description of formations encountered	from	to
<u>Red Clay & grey clay</u>	<u>0</u>	<u>60</u>
<u>Blue clay</u>	<u>60</u>	<u>100</u>
<u>Blue clay</u>	<u>100</u>	<u>146</u>
<u>good sand</u>	<u>146</u>	<u>172</u>

WELL LOCATION:
 sec 2 T 7 N R 10 E
4 miles N/E of Orange
 (distance) (direction) (nearest town)

WELL PURPOSE: home
 (home, irrigation, municipal, industrial)

- WELL COMPLETION DATA:
- (1) diameter (inches) 2"
 - (2) total depth (feet) 172'
 - (3) static water level (feet) 53 ^{below} above top of ground.
 - (4) casing PVC, 162'
 (material) (depth)
2" if telescope see back.
 (size)
 - (5) screen 10', 162'
 (length) (depth to top)
2" PVC
 (size) (material)
 - (6) pump 1 12
 (HP) (yield gpm)
electric
 (type power)
 - (7) electric log No
 (yes or no)
No
 (organization running log)
 - (8) how well bottom plugged sand
shark

DRILLERS REMARKS:


MISSISSIPPI DEPARTMENT OF NATURAL RESOURCES
 BUREAU OF LAND AND WATER RESOURCES

APR 28 1982

RECEIVED

If well telescopes please sketch and show depths.

GROUND LEVEL

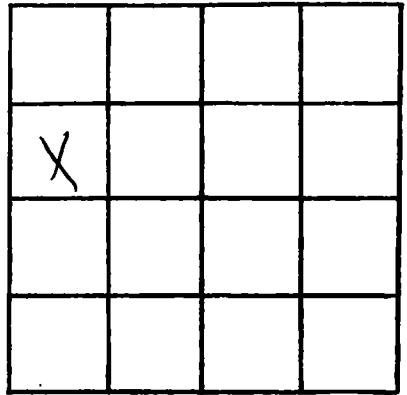

SECTION 2

Please indicate well location X.

ADDITIONAL INFORMATION

If more than one screen,
show locations of each on sketch.