

MISSISSIPPI DEPARTMENT OF NATURAL RESOURCES

Bureau of Land and Water Resources

Southport Mall

P.O. Box 10631

Jackson, Mississippi 39209

COASTAL DRILLING & WELL SERVICE DRILLERS LOG

ROUTE 1 BOX 618

BILOXI, MISS. 39552

county well located

Harrison
M
2361

11/14/81 19
date well completed

Harrison
county well located

LANDOWNER: J. P. Stehman
Hwy 67
Biloxi join
(mailing address)

| description of formations encountered | from | to |
|---------------------------------------|------|-----|
| Top Soil | 1 | 3 |
| Red Clay | 3 | 15 |
| White Sand + glass | 15 | 100 |
| Soft Blue Clay | 100 | 210 |
| Sandy Sand | 210 | 225 |
| Hard Blue Clay | 225 | 305 |
| fine water sand | 305 | 330 |
| good water sand | 330 | 345 |

WELL LOCATION:
sec. 5 T 2 N R 9 E
S W
(3 1/2) miles north Biloxi
(distance) (direction) (nearest town)

WELL PURPOSE: Home
(home, irrigation, municipal, industrial)

WELL COMPLETION DATA:

(1) diameter (inches) 2"

(2) total depth (feet) 345'

(3) static water level (feet) 20' below above top of ground.

(4) casing PVC, 335'
(material) (depth)
(size) If telescope see back.

(5) screen 10', 335'
(length) (depth to top)
2", PVC
(size) (material)

(6) pump Oneil, 14 gpm
(HP) (yield gpm)
1/2
(type power)

(7) electric log no
(yes or no)
(organization running log)

(8) how well bottom plugged 2" inch mesh valve
DRILLERS REMARKS: Sand Seal


DEPT. OF NATURAL RESOURCES
BUREAU OF LAND & WATER RESOURCES

JAN 15 1982

RECEIVED

If well telescopes please sketch and show depths.

GROUND LEVEL

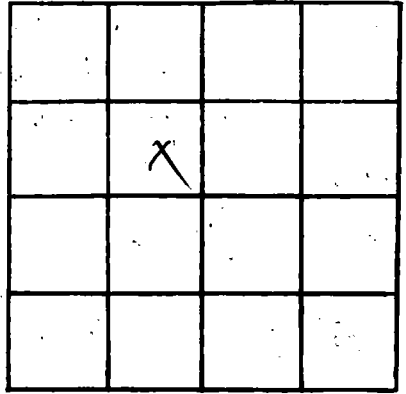

SECTION _____

Please indicate well location X.

ADDITIONAL INFORMATION

A series of horizontal lines for writing additional information.

If more than one screen, show locations of each on sketch.