

MISSISSIPPI DEPARTMENT OF NATURAL RESOURCES

Bureau of Land and Water Resources

Southport Mall

P.O. Box 10631

Jackson, Mississippi 39209

WATER WELL DRILLERS LOG

Harrison
M
2362

Nov. 23 1981
date well completed

Duncan Well Drilling
firm name

Harrison
county well located

LANDOWNER: Ed Clinton
Rt. 2 Box 40
Biloxi, Ms. 39532
(mailing address)

description of formations encountered	from	to
Clay	0	10
Sand	10	38
Blue Clay	38	160
Clay & Sand	160	190
Blue Clay	190	330
Gravel	330	345
Coarse Sand	345	360

WELL LOCATION:
sec. 5 T. 7 N. R. 9 E.
4 miles N.W. of Dillwell
(distance) (direction) (nearest town)

WELL PURPOSE: Home
(home, irrigation, municipal, industrial)

WELL COMPLETION DATA:

(1) diameter (inches) 2"

(2) total depth (feet) 360'

(3) static water level (feet) 25' below above top of ground.

(4) casing PVC, 350'
(material) (depth)

— if telescope see back.
(size)

(5) screen 10', 350'
(length) (depth to top)

2", PVC
(size) (material)

(6) pump 1 (HP) 8 (yield gpm)

electric
(type power)

(7) electric log — (yes or no)

— (organization running log)

(8) how well bottom plugged sand
shale

DRILLERS REMARKS:


DEPT. OF NATURAL RESOURCES
BUREAU OF LAND & WATER RESOURCES

FEB 11 1982

RECEIVED

If well telescopes please sketch and show depths.

GROUND LEVEL

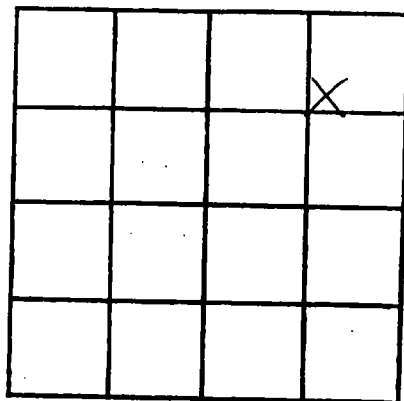

SECTION 5

Please indicate well location X.

ADDITIONAL INFORMATION

If more than one screen,
show locations of each on sketch.