

MISSISSIPPI DEPARTMENT OF NATURAL RESOURCES

Bureau of Land and Water Resources

Southport Mall

P.O. Box 10631

Jackson, Mississippi 39209

COASTAL DRILLING WATER WELL DRILLERS LOG

ROUTE 1 BOX 618

BILOXI, MISS. 39532

Hannin
DM
~~233~~
2363

3/10/82 date well completed

Hannin
 county well located

LANDOWNER: John Crowley
Woodmarket Road Rt E
Biloxi, Miss. 39532
 (mailing address)

description of formations encountered	from	to
<u>top soil</u>	<u>1</u>	<u>3</u>
<u>Red Clay</u>	<u>3</u>	<u>15</u>
<u>white sand</u>	<u>15</u>	<u>40</u>
<u>Soft Blue Clay</u>	<u>40</u>	<u>260</u>
<u>fine white sand</u>	<u>260</u>	<u>285</u>
<u>hard blue clay</u>	<u>285</u>	<u>420</u>
<u>fine white sand</u>	<u>420</u>	<u>440</u>
<u>Coarse white sand with shells</u>	<u>440</u>	<u>570</u>
<u>hard blue clay</u>	<u>570</u>	<u>590</u>
<u>fine white sand</u>	<u>590</u>	<u>620</u>
<u>Coarse white sand</u>	<u>620</u>	<u>640</u>

WELL LOCATION:
 sec 3 T 7 N R 10 E
Woodmarket
 (distance) (direction) (nearest town)

WELL PURPOSE: home
 (home, irrigation, municipal, industrial)

WELL COMPLETION DATA:

(1) diameter (inches) 2"

(2) total depth (feet) 640'

(3) static water level (feet) 40' below top of ground

(4) casing 40' 630'
 (material) (depth)
 (size) if telescope see back.

(5) screen 10' 630'
 (length) (depth to top)
20 flex
 (size) (material)

(6) pump 1/2 12
 (HP) (yield gpm)
5/8
 (type power)

(7) electric log no
 (yes or no)
 (organization running log)

(8) how well bottom plugged
2" hard white sand
 DRILLERS REMARKS:


DEPT. OF NATURAL RESOURCES
 BUREAU OF LAND & WATER RESOURCES

OCT 14 1982

RECEIVED

If well telescopes please sketch and show depths.

GROUND LEVEL

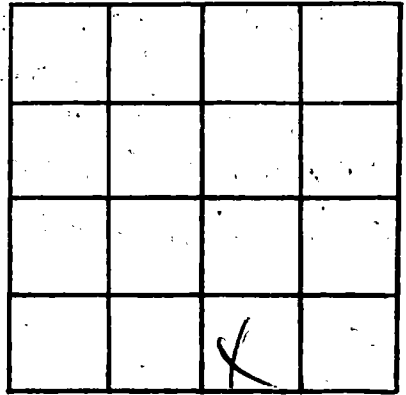

SECTION _____

Please indicate well location X.

ADDITIONAL INFORMATION

If more than one screen, show locations of each on sketch.