

MISSISSIPPI DEPARTMENT OF NATURAL RESOURCES

Bureau of Land and Water Resources

Southport Mall

P.O. Box 10631

Jackson, Mississippi 39209

WATER WELL DRILLERS LOG
COASTAL DRILLING & SERVICE CO.

ROUTE 1 BOX 618

firm name
BILOXI MISS. 39532

county well located

Harrison
M
2364

6/1/82
date well completed

19

Harrison

LANDOWNER

description of formations encountered

from

to

Paul Kennedy
Old Bay Road
Biloxi MS 39532
(mailing address)

top soil	1	3
red clay	3	15
white sand	15	70
grey sand	70	110
soft blue clay	110	215
shell	215	220
soft blue clay	220	290
hard blue clay	290	350
grey water sand	350	370
grey water sand	370	395

WELL LOCATION:

sec. 18 T 7 N R 9 E
S W
Magnolia Bend
(distance) (direction) (nearest town)

WELL PURPOSE: home
(home, irrigation, municipal, industrial)

WELL COMPLETION DATA:

- (1) diameter (inches) 4 1/2"
- (2) total depth (feet) 395'
- (3) static water level (feet) 10' below top of ground.
- (4) casing PVC 380' (material) (depth)
4 1/2" (size) if telescope see back.
- (5) screen 15' 380' (length) (depth to top)
2" (size) PVC (material)
- (6) pump 1/2 HP 20 (HP) (yield gpm)
Ele (type power)
- (7) electric log No (yes or no)

(organization running log)

(8) how well bottom plugged
2' sand wash value
DRILLERS REMARKS: 19-12


DEPT. OF NATURAL RESOURCES
BUREAU OF LAND & WATER RESOURCES

DEC - 1 1982

RECEIVED

If well telescopes please sketch and show depths.

GROUND LEVEL

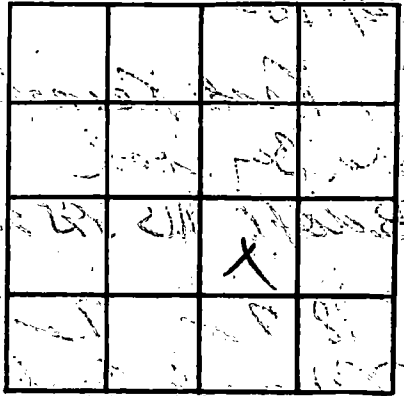

SECTION _____

Please indicate well location X.

ADDITIONAL INFORMATION

120'-4" PVC casing

260'-2" PVC casing

15'-2" PVC screen

2" headwork valve
19-B

If more than one screen, show locations of each on sketch.