

MISSISSIPPI DEPARTMENT OF NATURAL RESOURCES

Bureau of Land and Water Resources

Southport Mall

P.O. Box 10631

Jackson, Mississippi 39209

WATER WELL DRILLERS LOG

Harrison
M
2370

7-10 1982 BRADEN Pump Well HARRISON
 date well completed firm name county well located
 SERVICE, INC.

LANDOWNER: DR. JAMES E SMITH
 Rt. 8 Box 115
 Biloxi, MS-39532
 (mailing address)

WELL LOCATION:
 sec. 22 T 7 S R. 10 W
 1 miles NW of Biloxi
 (distance) (direction) (nearest town)

WELL PURPOSE: HOME
 (home, irrigation, municipal, industrial)

WELL COMPLETION DATA:

(1) diameter (inches) 4" x 2"
 (2) total depth (feet) 380
 (3) static water level (feet) 40 below top of ground.
 (4) casing PVC 370 (material) (depth)
 4" x 2" (size) if telescope see back.
 (5) screen 10 370 (length) (depth to top)
 2" PVC unbarbed (size) (material)
 (6) pump 1 1/2 sub. 70 (HP) (yield gpm)
 2700 1/2 (type power)
 (7) electric log No (yes or no)
 (organization running log)

description of formations encountered	from	to
Surface	0	12
White Clay	12	80
White Sand	80	140
Blue Clay	140	250
Sand	250	265
Blue Clay	265	340
Grey Sand	340	380

(8) how well bottom plugged
 2" Sand Shock



DRILLERS REMARKS:

DEPT. OF NATURAL RESOURCES
 BUREAU OF LAND & WATER RESOURCES

JUL 29 1982

RECEIVED

If well telescopes please sketch and show depths.

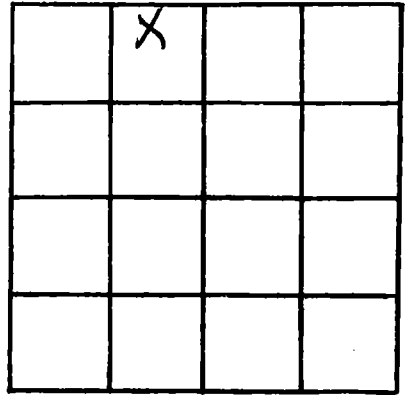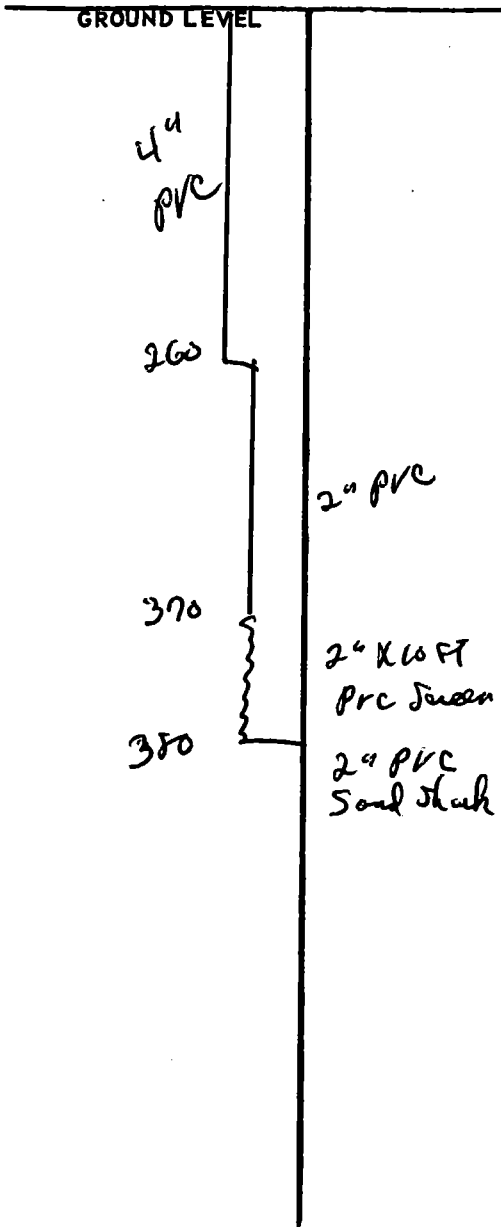

SECTION 27

Please indicate well location X.

ADDITIONAL INFORMATION

A series of horizontal lines for additional information, currently blank.

If more than one screen, show locations of each on sketch.