

MISSISSIPPI DEPARTMENT OF NATURAL RESOURCES

Bureau of Land and Water Resources

Southport Mall

P.O. Box 10631

Jackson, Mississippi 39209

WATER WELL DRILLERS LOG

<u>Harrison</u>
<u>M</u>
<u>2371</u>

Aug. 13 1982

Duncan Well Drilling Harrison

date well completed

firm name

county well located

LANDOWNER: Wolfgang Hauschild  
401-A Overman Ave  
Biloxi, Ms.  
 (mailing address)

description of formations encountered

from

to

<u>Top Sand</u>	<u>0</u>	<u>40</u>
<u>Clay</u>	<u>40</u>	<u>85</u>
<u>Blue Clay</u>	<u>85</u>	<u>272</u>
<u>Fine Sand</u>	<u>272</u>	<u>330</u>
<u>Coarse Sand</u>	<u>330</u>	<u>378</u>

WELL LOCATION:

sec. 5 T. 7 N. R. 9 E.  
4 miles N.W. of D'Arbonne  
 (distance) (direction) (nearest town)

WELL PURPOSE: Home  
 (home, irrigation, municipal, industrial)

WELL COMPLETION DATA:

- (1) diameter (inches) 2"
- (2) total depth (feet) 378 ft.
- (3) static water level (feet) 20' below above top of ground.
- (4) casing PVC, 368'  
 (material) (depth)  
 (size) If telescope see back.
- (5) screen 10', 368'  
 (length) (depth to top)  
2", PVC  
 (size) (material)
- (6) pump 1, 10  
 (HP) (yield gpm)  
electric  
 (type power)
- (7) electric log \_\_\_\_\_  
 (yes or no)

DEPT. OF NATURAL RESOURCES  
 BUREAU OF LAND & WATER RESOURCES

AUG 30 1982


(8) how well bottom plugged sand  
shank

DRILLERS REMARKS:

RECEIVED

If well telescopes please sketch and show depths.

GROUND LEVEL

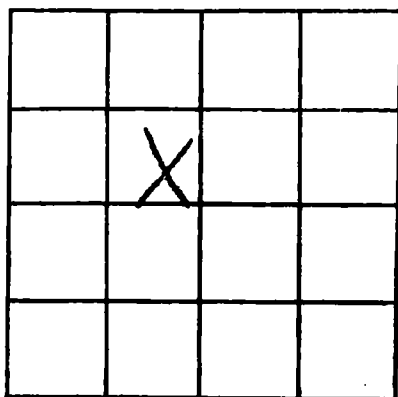

SECTION 5

Please indicate well location X.

ADDITIONAL INFORMATION

If more than one screen, show locations of each on sketch.