

MISSISSIPPI DEPARTMENT OF NATURAL RESOURCES

Bureau of Land and Water Resources

Southport Mall

P.O. Box 10631

Jackson, Mississippi 39209

WATER WELL DRILLERS LOG

COASTAL DRILLING & SERVICE CO.

Hanson
M
2372

10/18/82
date well completed

ROUTE 1 BOX 618
BILLO, MISS. 39537

Drum name
county well located

LANDOWNER: M. Fickly
Shore Chase Road
Bilbo, Miss
(mailing address)

description of formations encountered	from	to
top soil	1	3
red clay	3	15
soft blue clay	15	65
Coarse white sand	65	90

WELL LOCATION:
9 ^{sec} T. 7 ^N R. 10 ^E
2 1/2 miles South Wadsworth
(distance) (direction) (nearest town)

WELL PURPOSE: home
(home, irrigation, municipal, industrial)

WELL COMPLETION DATA:

(1) diameter (inches) 2"

(2) total depth (feet) 90'

(3) static water level (feet) 30' ¹ below top of ground.

(4) casing pvc 80'
(material) (depth)
(size) if telescope see back.

(5) screen 10' 80'
(length) (depth to top)
2" pvc
(size) (material)

(6) pump 2HP 30
(HPI) (yield gpm)
Elc
(type power)


(7) electric log no
(yes or no)
(organization running log)

(8) how well bottom plugged
2" back wash valve
DRILLERS REMARKS: 19-B

DEPT. OF NATURAL RESOURCES
BUREAU OF LAND & WATER RESOURCES
NOV 30 1982
RECEIVED

If well telescopes please sketch and show depths.

GROUND LEVEL

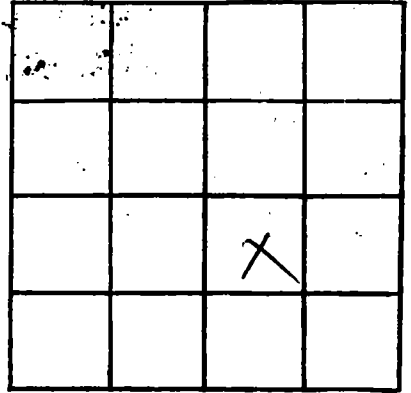

SECTION _____

Please indicate well location X.

ADDITIONAL INFORMATION

If more than one screen, show locations of each on sketch.