

MISSISSIPPI DEPARTMENT OF NATURAL RESOURCES

Bureau of Land and Water Resources

Southport Mall

P.O. Box 10631

Jackson, Mississippi 39209

COASTAL DRILLING & SERVICE CO. WATER WELL DRILLERS LOG

Harrison  
M  
2373

ROUTE 1 BOX 618

Harrison

10/19/82  
 date well completed

BILOXI. MISS 39532  
 firm name

county well located

LANDOWNER

description of formations encountered

from

to

Wm Harrison  
Rt 5 Box 229 I

<u>Top Soil</u>	<u>1</u>	<u>3</u>
<u>Gravel Sand</u>	<u>3</u>	<u>7.5</u>
<u>Coarse white Sand</u>	<u>15</u>	<u>60</u>
<u>Soft Blue Clay</u>	<u>60</u>	<u>210</u>
<u>Grey Water Sand</u>	<u>210</u>	<u>240</u>
<u>Soft Blue Clay</u>	<u>240</u>	<u>310</u>
<u>Hard Blue Clay</u>	<u>310</u>	<u>400</u>
<u>Grey Water Sand</u>	<u>400</u>	<u>415</u>
<u>Soft White Sand</u>	<u>415</u>	<u>440</u>

Biloxi MS 39532  
 (mailing address)

WELL LOCATION:

sec 12 T 2 N R 10 E  
Whitewater  
 (distance) (direction) (nearest town)

WELL PURPOSE:

(home, irrigation, municipal, industrial)

WELL COMPLETION DATA:

- (1) diameter (inches) 2"
- (2) total depth (feet) 440'
- (3) static water level (feet) 20' below above top of ground.
- (4) casing PVC, 430'  
 (material) (depth)
- (size) If telescope see back.
- (5) screen 10', 430'  
 (length) (depth to top)
- (size) 2" (material) PVC
- (6) pump 1/4 14  
 (HP) (yield gpm)
- (type power) Ele
- (7) electric log no  
 (yes or no)

(organization running log)

(8) how well bottom plugged


Drillers Remarks: 19-B

DEPT. OF NATURAL RESOURCES  
 BUREAU OF LAND & WATER RESOURCES

DEC - 1 1982  
 RECEIVED

If well telescopes please sketch and show depths.

GROUND LEVEL

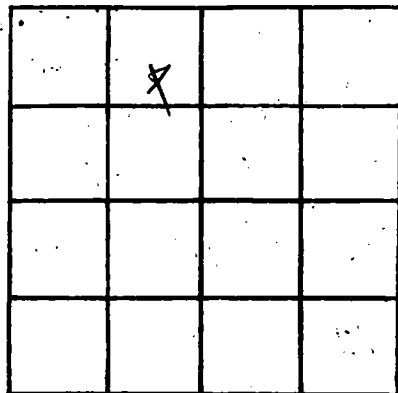

SECTION \_\_\_\_\_

Please indicate well location X.

ADDITIONAL INFORMATION

If more than one screen, show locations of each on sketch.