

MISSISSIPPI DEPARTMENT OF NATURAL RESOURCES

Bureau of Land and Water Resources

Southport Mall

P.O. Box 10631

Jackson, Mississippi 39209

WATER WELL DRILLERS LOG

Harrison
M
2374

2/8/83 19
 date well completed

Syman Well
 firm name

Harrison
 county well located

LANDOWNER: Paul Benton
Rt. 2, Box 303-H
N Biloxi 39532
 (mailing address)

description of formations encountered	from	to
<u>Pine Sand & Rotten wood</u>	<u>0</u>	<u>40</u>
<u>Blue & Gray Gumbo Clay</u>	<u>40</u>	<u>190</u>
<u>Light Blue Gumbo CLAY</u>	<u>190</u>	<u>280</u>
<u>Good Sand</u>	<u>280</u>	<u>304</u>

WELL LOCATION:
 sec. 3 T. 7 N. R. 9 E
5 miles N of Biloxi
 (distance) (direction) (nearest town)

WELL PURPOSE: Home
 (home, irrigation, municipal, industrial)

- WELL COMPLETION DATA:
- (1) diameter (inches) 2"
 - (2) total depth (feet) 304'
 - (3) static water level (feet) 30 below top of ground.
 - (4) casing PVC, 294'
 (material) (depth)
2" if telescope see back.
 (size)
 - (5) screen 10', 294'
 (length) (depth to top)
2" PVC
 (size) (material)
 - (6) pump 1 (HP) (yield gpm)
electric
 (type power)
 - (7) electric log No
 (yes or no)
NO
 (organization running log)
 - (8) how well bottom plugged Sand
shark

DEPT. OF NATURAL RESOURCES
 BUREAU OF LAND & WATER RESOURCES


MAY 1 1984

RECEIVED

DRILLERS REMARKS:

If well telescopes please sketch and show depths.

GROUND LEVEL

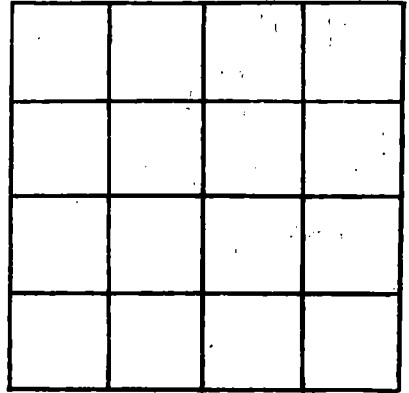

SECTION _____

Please indicate well location X.

ADDITIONAL INFORMATION

If more than one screen,
show locations of each on sketch.