

MISSISSIPPI DEPARTMENT OF NATURAL RESOURCES

Bureau of Land and Water Resources

Southport Mall

P.O. Box 10631

Jackson, Mississippi 39209

WATER WELL DRILLERS LOG

Harrison
M
2376

2-25 1983 Broden Pump & Well Harrison
 date well completed firm name county well located

LANDOWNER: Bob Roberts
Camp 4 Tracts Rd
Biloxi, Miss.
 (mailing address)

WELL LOCATION:
 sec. 14 T. 7 R. 10
2 miles SW of Calata Lake
 (distance) (direction) (nearest town)

WELL PURPOSE: Home
 (home, irrigation, municipal, industrial)

WELL COMPLETION DATA:
 (1) diameter (inches) 2 1/2
 (2) total depth (feet) 380
 (3) static water level (feet) 35 below above top of ground.
 (4) casing PVC, 360
 (material) (depth)
2" If telescope see back.
 (size)
 (5) screen 10, 360
 (length) (depth to top)
2", PVC Under-bow
 (size) (material)
 (6) pump 1, 10
 (HP) (yield gpm)
220V 1Ø
 (type power)
 (7) electric log No
 (yes or no)
 (organization running log)

description of formations encountered	depth	
	from	to
Surface	0	4
Clay	4	60
sand	60	70
Clay	70	120
sand	120	125
Clay	125	140
sand & clay breaks	140	160
Clay	160	240
sand + clay breaks	240	280
Clay	280	320
sand	320	375
Clay	375	380

DEPT. OF NATURAL RESOURCES
 BUREAU OF LAND & WATER RESOURCES


(8) how well bottom plugged
2 1/2" PVC Sand Shred
 DRILLERS REMARKS: TIP
10 ft

MAR - 8 1983

RECEIVED

If well telescopes please sketch and show depths.

GROUND LEVEL

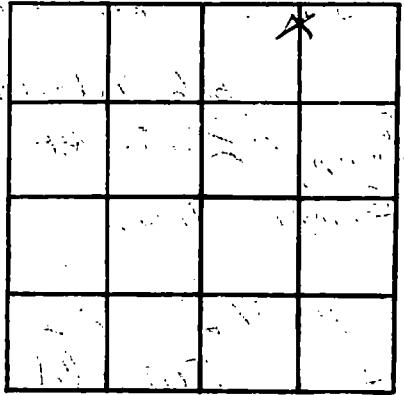

SECTION 14

Please indicate well location X.

ADDITIONAL INFORMATION

If more than one screen, show locations of each on sketch.