

MISSISSIPPI DEPARTMENT OF NATURAL RESOURCES

Bureau of Land and Water Resources

Southport Mall

P.O. Box 10631

Jackson, Mississippi 39209

WATER WELL DRILLERS LOG
COASTAL DRILLING & SERVICE CO.

ROUTE 1 BOX 618

BILOXI MISS. 39532

Harrison
M
2377

Date well completed

Firm name

county well located

LANDOWNER

description of formations encountered

from to

Apple Valley
Woodward/Biloxi Mo
(mailing address)

<u>Top Soil</u>	<u>1</u>	<u>3</u>
<u>Red Clay</u>	<u>3</u>	<u>15</u>
<u>Super Sand</u>	<u>15</u>	<u>40</u>
<u>Silt + Blue Clay</u>	<u>40</u>	<u>70</u>
<u>Sand + Sand</u>	<u>70</u>	<u>90</u>
<u>Silt + Blue Clay</u>	<u>90</u>	<u>210</u>
<u>Light Blue Clay</u>	<u>210</u>	<u>285</u>
<u>fine water sand</u>	<u>285</u>	<u>310</u>
<u>good water sand</u>	<u>310</u>	<u>330</u>

WELL LOCATION:

sec 5 T 7 N R 10 E
S W
Coalville
(distance) miles (direction) of (nearest town)

WELL PURPOSE: home
(home, irrigation, municipal, industrial)

WELL COMPLETION DATA:

- (1) diameter (inches) 2"
- (2) total depth (feet) 330'
- (3) static water level (feet) 45' below top of ground.
- (4) casing stc 320'
(material) (depth)
- (size) If telescope see back.
- (5) screen 10' 320'
(length) (depth to top)
- (size) (material) stc
- (6) pump None 12
(HP) (yield gpm)
- (type power) ele
- (7) electric log no
(yes or no)

(organization running log)

(8) how well bottom plugged
2" back in hole
DRILLERS REMARKS: 19-B


DEPT. OF NATURAL RESOURCES
BUREAU OF LAND & WATER RESOURCES

AUG 16 1983

RECEIVED

If well telescopes please sketch and show depths.

GROUND LEVEL

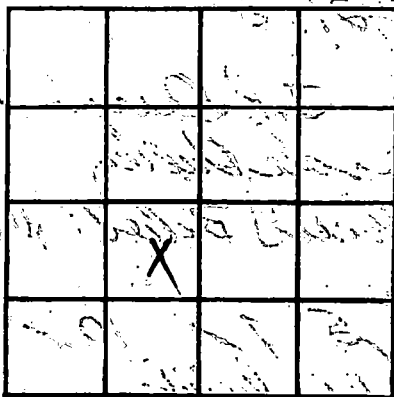

SECTION _____

Please indicate well location X.

ADDITIONAL INFORMATION

If more than one screen, show locations of each on sketch.