

MISSISSIPPI DEPARTMENT OF NATURAL RESOURCES
Bureau of Land and Water Resources
 Southport Mall
 P.O. Box 10631
 Jackson, Mississippi 39209
WATER WELL DRILLERS LOG

Harrison
M
2380

6-3 1983 McGill Wells INC Harrison
 date well completed firm name county well located

LANDOWNER: Robert Fisher
Old Cedar Lake Road
Biloxi, MS
 (mailing address)

WELL LOCATION:
 sec. 16 T 7 N R 10 E
 (S) (W)
1 miles North of Biloxi
 (distance) (direction) (nearest town)

WELL PURPOSE:
 (home, irrigation, municipal, industrial)

WELL COMPLETION DATA:

(1) diameter (inches) 2"

(2) total depth (feet) 480'

(3) static water level (feet) 160' below above top of ground.
 (PVC)

(4) casing PVC 470'
 (material) (depth)

(size) if telescope see back.

(5) screen 10' 470'
 (length) (depth to top)
2" caslot sch 80 PVC
 (size) (material)

(6) pump 1 8
 (HP) (yield gpm)
etc
 (type power)

(7) electric log —
 (yes or no)
 (organization running log)

(8) how well bottom plugged SAND
SEAL

description of formations encountered	from	to
	<u>MUD</u>	<u>0</u>
<u>SAND</u>	<u>40</u>	<u>60</u>
<u>MUD</u>	<u>60</u>	<u>300</u>
<u>SAND</u>	<u>300</u>	<u>310</u>
<u>MUD</u>	<u>310</u>	<u>420</u>
<u>SAND</u>	<u>420</u>	<u>440</u>
<u>SAND</u>	<u>440</u>	<u>460</u>
<u>SAND</u>	<u>460</u>	<u>480</u>

DEPT. OF NATURAL RESOURCES
 BUREAU OF LAND & WATER RESOURCES


AUG 10 1983

RECEIVED

DRILLERS REMARKS:

If well telescopes please sketch and show depths.

GROUND LEVEL

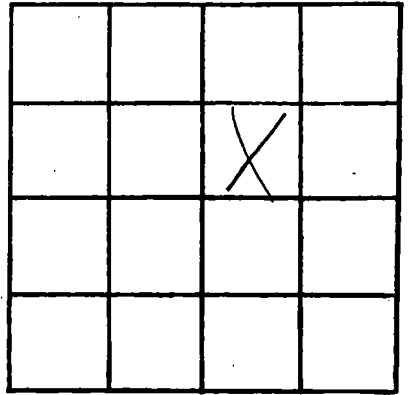

SECTION 10

Please indicate well location X.

ADDITIONAL INFORMATION

If more than one screen,
show locations of each on sketch.