

MISSISSIPPI DEPARTMENT OF NATURAL RESOURCES

Bureau of Land and Water Resources

Southport Mall

P.O. Box 10631

Jackson, Mississippi 39209

WATER WELL DRILLERS LOG  
COASTAL DRILLING & SERVICE CO.

ROUTE 1 BOX 618

BILOXI, MISS. 39532

county well located

Harrison  
M  
2385

7/12/83 19  
date well completed

from name

Harrison

LANDOWNER: Alan Sumner

description of formations encountered

from

to

Pt 3 Ref 63

Biloxi, Ms  
(mailing address)

<u>Topsoil</u>	<u>1</u>	<u>3</u>
<u>Red Clay</u>	<u>3</u>	<u>15</u>
<u>Super sand</u>	<u>15</u>	<u>30</u>
<u>Red Clay</u>	<u>30</u>	<u>65</u>
<u>Soft Blue Clay</u>	<u>65</u>	<u>210</u>
<u>Light water sand</u>	<u>210</u>	<u>270</u>
<u>Good water sand</u>	<u>270</u>	<u>248</u>

WELL LOCATION:

sec. 4 T. 2 N. R. 10 E. W.  
Coahuila  
(distance) (direction) of (nearest town)

WELL PURPOSE: Home  
(home, irrigation, municipal, industrial)

WELL COMPLETION DATA:

- (1) diameter (inches) 2"
- (2) total depth (feet) 248'
- (3) static water level (feet) 60' below above top of ground.
- (4) casing PVC 238' (material) (depth)
- (size) If telescope see back.
- (5) screen 10' 238' (length) (depth to top)
- 2" (size) PVC (material)
- (6) pump 1/2 12 (HP) (yield gpm)
- 5/8 (type power)
- (7) electric log No (yes or no)
- (organization running log)

DEPT. OF NATURAL RESOURCES  
BUREAU OF LAND & WATER RESOURCES

APR - 4 1984


RECEIVED

(8) how well bottom plugged

2' sand plug placed  
DRILLERS REMARKS: 19-18

If well telescopes please sketch and show depths.

GROUND LEVEL

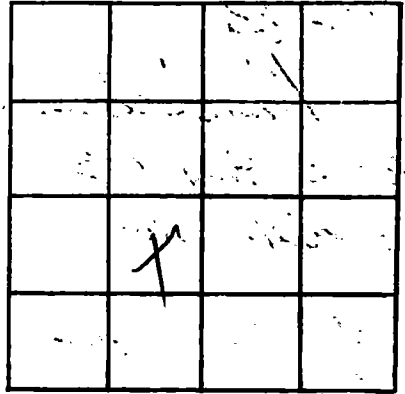

SECTION \_\_\_\_\_

Please indicate well location X.

ADDITIONAL INFORMATION

If more than one screen,  
show locations of each on sketch.