

MISSISSIPPI DEPARTMENT OF NATURAL RESOURCES

Bureau of Land and Water Resources

Southport Mall

P.O. Box 10631

Jackson, Mississippi 39209

WATER WELL DRILLERS LOG  
COASTAL DRILLING & SERVICE CO.

Hennis  
M M  
2387

7/20/83  
date well completed

ROUTE 1 BOX 618  
firm name

Hennis  
county well located

R. Robertson  
LANDOWNER

MISS. 39532  
BLOX#

description of formations encountered	from	to
<u>top soil</u>	<u>1</u>	<u>3</u>
<u>Red Clay</u>	<u>3</u>	<u>15</u>
<u>White Sand</u>	<u>15</u>	<u>30</u>
<u>Grey Sand</u>	<u>30</u>	<u>45</u>
<u>Soft Blue Clay</u>	<u>45</u>	<u>290</u>
<u>Hard Blue Clay</u>	<u>290</u>	<u>340</u>
<u>fine just sand</u>	<u>340</u>	<u>350</u>
<u>good water sand</u>	<u>350</u>	<u>375</u>

Rt 1  
Bilaji MS  
(mailing address)

WELL LOCATION:

sec. 8 T. 7 N. R. 9 E. W.  
South of I 10  
(distance) mile (direction) of (nearest town)

WELL PURPOSE: pond  
(home, irrigation, municipal, industrial)

WELL COMPLETION DATA:

- (1) diameter (inches) 2"
- (2) total depth (feet) 325'
- (3) static water level (feet) 60' below above top of ground.
- (4) casing PVC, 365'  
(material) (depth)  
(size) if telescope see back.
- (5) screen 10', 365'  
(length) (depth to top)  
2", PVC  
(size) (material)
- (6) pump 1/2 10  
(HP) (yield gpm)  
ell  
(type power)
- (7) electric log no  
(yes or no)

(organization running log)

(8) how well bottom plugged  
20' additional water  
19.13

DRILLERS REMARKS:


DEPT. OF NATURAL RESOURCES  
BUREAU OF LAND & WATER

JUL 23 1984

RECEIVED

If well telescopes please sketch and show depths.

GROUND LEVEL

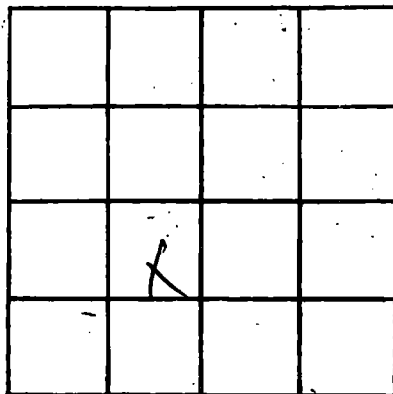

SECTION \_\_\_\_\_

Please indicate well location X.

ADDITIONAL INFORMATION

If more than one screen, show locations of each on sketch.