

MISSISSIPPI DEPARTMENT OF NATURAL RESOURCES

Bureau of Land and Water Resources

Southport Mall

P.O. Box 10631

Jackson, Mississippi 39209

WATER WELL DRILLERS LOG

COASTAL DRILLING & SERVICE *Hamison*

Hamison
M
2389

02/83
Date well completed

ROUTE *1* BOX *618*

County well located

LANDOWNER: *Leo Nelson*
Big Ridge + Long Pond
Biloxi MS
(mailing address)

description of formations encountered	from	to
<i>top soil</i>	<i>1</i>	<i>3</i>
<i>Red Clay</i>	<i>3</i>	<i>15</i>
<i>White Soil</i>	<i>15</i>	<i>35</i>
<i>Sandy Soil</i>	<i>35</i>	<i>70</i>
<i>Soft Blue Clay</i>	<i>70</i>	<i>200</i>
<i>Fast Sand</i>	<i>200</i>	<i>240</i>
<i>Soft Blue Clay</i>	<i>240</i>	<i>310</i>
<i>Hard Blue Clay</i>	<i>310</i>	<i>470</i>
<i>fine water sand</i>	<i>470</i>	<i>500</i>
<i>Hard Blue Clay</i>	<i>500</i>	<i>710</i>
<i>fine water sand</i>	<i>710</i>	<i>750</i>
<i>Coarse sand water sand</i>	<i>750</i>	<i>820</i>

WELL LOCATION:
sec. *7* T. *7* N. R. *9* E. W. *9*
Cypress Creek
(distance) (direction) (nearest town)

WELL PURPOSE: *home*
(home, irrigation, municipal, industrial)

WELL COMPLETION DATA:

(1) diameter (inches) *4 1/2"*

(2) total depth (feet) *820'*

(3) static water level (feet) *20'* below above top of ground.

(4) casing *PVC*, *805'*
(material) (depth)
4 1/2"
(size) If telescope see back.

(5) screen *15'*, *805'*
(length) (depth to top)
2", *PVC*
(size) (material)

(6) pump *1/2 hp*, *25*
(HP) (yield gpm)
5hp
(type power)

(7) electric log *no*
(yes or no)

(organization running log)

DEPT. OF NATURAL RESOURCES
BUREAU OF LAND AND WATER RESOURCES

APR - 6 1984

RECEIVED

(8) how well bottom plugged
2' back hole drilled
DRILLERS REMARKS: *19-B*


If well telescopes please sketch and show depths.

GROUND LEVEL

140' - 4" PVC casing

665' - 2" PVC casing

15' - 2" PVC screen
2" back wash valve
19-B

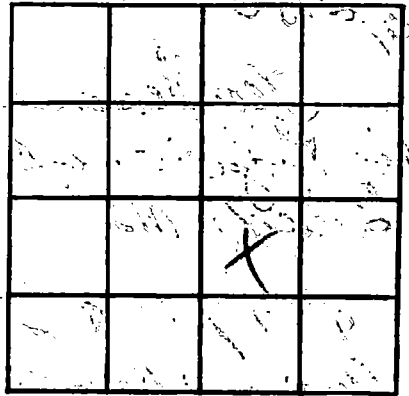

SECTION _____

Please indicate well location X.

ADDITIONAL INFORMATION

If more than one screen, show locations of each on sketch.