

MISSISSIPPI DEPARTMENT OF NATURAL RESOURCES

Bureau of Land and Water Resources

Southport Mall

P.O. Box 10631

Jackson, Mississippi 39209

WATER WELL DRILLERS LOG

Hanson  
M  
2398

10/12/83 date well completed 19 Bradley Pump & Well Sew. Inc. firm name Harrison county well located

LANDOWNER: Ray Tocol  
Rt. 5, Box 52  
N. Biloxi, Ms. 39532  
 (mailing address)

description of formations encountered	from	to
<u>Green clay</u>	<u>0</u>	<u>20</u>
<u>Green clay</u>	<u>20</u>	<u>100</u>
<u>Clay &amp; sand</u>	<u>120</u>	<u>140</u>
<u>fine sand</u>	<u>140</u>	<u>160</u>
<u>fine sand</u>	<u>160</u>	<u>180</u>
<u>Clay</u>	<u>180</u>	<u>200</u>
<u>white clay</u>	<u>200</u>	<u>260</u>
<u>Clay</u>	<u>260</u>	<u>280</u>
<u>blue clay</u>	<u>280</u>	<u>360</u>
<u>sand</u>	<u>360</u>	<u>400</u>

WELL LOCATION:  
 sec. 17 T. 7 S. R. 9 E.  
2 miles N of Biloxi  
 (distance) (direction) (nearest town)

WELL PURPOSE: home  
 (home, irrigation, municipal, industrial)

WELL COMPLETION DATA:  
 (1) diameter (inches) 4"  
 (2) total depth (feet) 400  
 (3) static water level (feet) 20' below above top of ground.  
 (4) casing PVC, 380'  
 (material) (depth)  
4" If telescope see back.  
 (size)  
 (5) screen 10', 380'  
 (length) (depth to top)  
4", PVC  
 (size) (material)  
 (6) pump 1 1/2, 40  
 (HP) (yield gpm)  
230V  
 (type power)  
 (7) electric log no  
 (yes or no)

(organization running log)

(8) how well bottom plugged 4x2  
backward check valve

DRILLERS REMARKS: 10 ft  
tail pipe


DEPT. OF NATURAL RESOURCES  
 BUREAU OF LAND & WATER RESOURCES

OCT 17 1983

RECEIVED

If well telescopes please sketch and show depths.

GROUND LEVEL

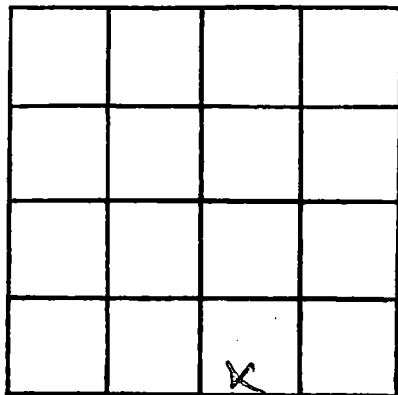

SECTION 17

Please indicate well location X.

ADDITIONAL INFORMATION

If more than one screen,  
show locations of each on sketch.