

MISSISSIPPI DEPARTMENT OF NATURAL RESOURCES

Bureau of Land and Water Resources

Southport Mall

P.O. Box 10631

Jackson, Mississippi 39209

WATER WELL DRILLERS LOG  
COASTAL DRILLING & SERVICE CO.

ROUTE 1 BOX 618

Hamilton county well located

MISS. 39532

Hamilton  
M  
2400  
10/24/84  
date well completed

LANDOWNER

Benny Adkins

description of formations encountered

from to

Pt 4

Top Soil

1 3

Calais MS

Red Clay

3 15

(mailing address)

White Sand

15 30

WELL LOCATION:

sec. 18 T 7 N R 9 E S W

Sugar Sand

30 65

Magnolia Bend

(distance) (direction) (nearest town)

Soft Blue Clay

65 215

fine water sand

215 220

Hard Blue Clay

220 360

fine water sand

360 375

good water sand

375 390

WELL PURPOSE:

(home, irrigation, municipal, industrial)

home

WELL COMPLETION DATA:

(1) diameter (inches)

4 1/2"

(2) total depth (feet)

390'

(3) static water level (feet) below above top of ground.

30' below

(4) casing (material) (depth)

Pvc 375'

4 1/2" (size) if telescope see back.

(5) screen (length) (depth to top)

15' 375'

2" (size) Pvc (material)

(6) pump (HP) (yield gpm)

1/2 HP 20

Ele (type power)

(7) electric log (yes or no)

no

(organization running log)

(8) how well bottom plugged

2" sand packed water

DRILLERS REMARKS:

19-15

DEPT. OF NATURAL RESOURCES  
BUREAU OF LAND & WATER RESOURCES

APR - 6 1984

RECEIVED

If well telescopes please sketch and show depths.


GROUND LEVEL

160' - 4" PVC  
Casing

215' - 2" PVC Casing

15' 2" PVC Screen

2" back Wash Valve  
19-B

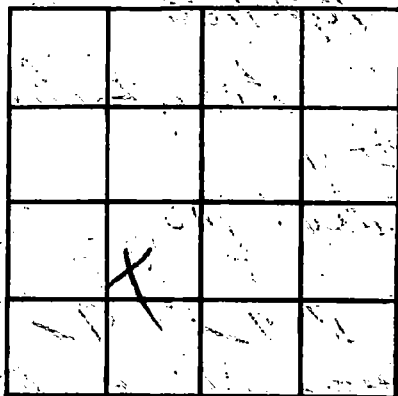

SECTION \_\_\_\_\_

Please indicate well location X.

ADDITIONAL INFORMATION

If more than one screen,  
show locations of each on sketch.