

MISSISSIPPI DEPARTMENT OF NATURAL RESOURCES

Bureau of Land and Water Resources

Southport Mall

P.O. Box 10631

Jackson, Mississippi 39209

WATER WELL DRILLERS LOG

Harrison
M
2401

10/29/83 19 Lyman Well Co Harrison
 date well completed firm name county well located

LANDOWNER: Wayne Barnett
Atkinson Rd
N. Biloxi
 (mailing address)

description of formations encountered	from	to
Clay	0	20
White sand	20	80
Blue clay	80	150
salt & pepper sand	150	190

WELL LOCATION:
 sec. 22 T 7 N R 10 E
 (distance) miles (direction) of (nearest town)
in Biloxi

WELL PURPOSE: Home
 (home, irrigation, municipal, industrial)

WELL COMPLETION DATA:

(1) diameter (inches) 4"

(2) total depth (feet) 190'

(3) static water level (feet) 15 below above top of ground.

(4) casing PVC, 180'
 (material) (depth)
4" if telescope see back.
 (size)

(5) screen 10', 180'
 (length) (depth to top)
4", PVC
 (size) (material)

(6) pump 1, 25
 (HP) (yield gpm)
electric
 (type power)

(7) electric log no
 (yes or no)
no
 (organization running log)


(8) how well bottom plugged Sand
Shank

DRILLERS REMARKS: _____

MISSISSIPPI DEPARTMENT OF NATURAL RESOURCES
 BUREAU OF LAND & WATER RESOURCES
 APR 26 1984
 RECEIVED

If well telescopes please sketch and show depths.

GROUND LEVEL

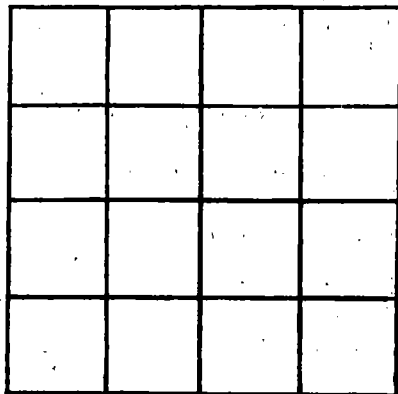

SECTION _____

Please indicate well location X.

ADDITIONAL INFORMATION

If more than one screen,
show locations of each on sketch.