

HARRISON  
M  
2406

MISSISSIPPI DEPARTMENT OF NATURAL RESOURCES  
 Bureau of Land and Water Resources  
 Southport Mall  
 P.O. Box 10631  
 Jackson, Mississippi 39209  
**WATER WELL DRILLERS LOG**

Jan 9 1984 Duncan Well Drilling Harrison  
 Date well completed firm name county well located

LANDOWNER: Harold Clynton  
Rt. 2 Box 44  
Biloxi, Ms. 39532  
 (mailing address)

Description of formations encountered	from	to
<u>Clay</u>	<u>0</u>	<u>40</u>
<u>Coarse sand</u>	<u>40</u>	<u>50</u>

WELL LOCATION:  
 sec. 7 T. 7 N. R. 9 E.  
5 miles N of Back Bay Biloxi  
 (distance) (direction) (nearest town)

WELL PURPOSE: Home  
 (home, irrigation, municipal, industrial)

WELL COMPLETION DATA:

(1) diameter (inches) 2"

(2) total depth (feet) 50'

(3) static water level (feet) top below above top of ground.

(4) casing PVC, 40'  
 (material) (depth)  
 (size) If telescope see back.

(5) screen 10', 40'  
 (length) (depth to top)  
2", PVC  
 (size) (material)

(6) pump 1/2 8  
 (HP) (yield gpm)  
electric  
 (type power)

(7) electric log \_\_\_\_\_  
 (yes or no)  
 \_\_\_\_\_  
 (organization running log)


(8) how well bottom plugged Sand  
Shark

DRILLERS REMARKS: \_\_\_\_\_

DEPT. OF NATURAL RESOURCES  
 BUREAU OF LAND & WATER RESOURCES  
 FEB - 7 1984  
**RECEIVED**

If well telescopes please sketch and show depths.

GROUND LEVEL

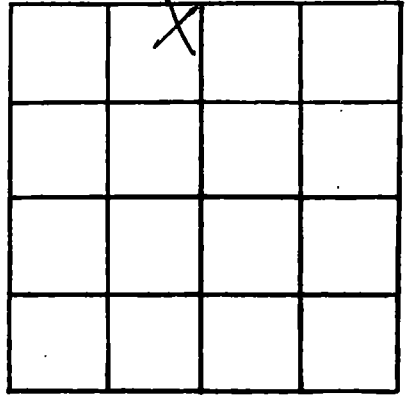

SECTION 7

Please indicate well location X.

ADDITIONAL INFORMATION

If more than one screen,  
show locations of each on sketch.