

Harrison
M
2411

MISSISSIPPI DEPARTMENT OF NATURAL RESOURCES
 Bureau of Land and Water Resources
 Southport Mall
 P.O. Box 10631
 Jackson, Mississippi 39209
WATER WELL DRILLERS LOG

6/22/84 19 Lyman Well Co. Harrison
 date well completed firm name county well located

LANDOWNER: Joseph Whittington
16212 Racetrack Rd.
Biloxi 39532
 (mailing address)

description of formations encountered	from	to
<u>White Sand</u>	<u>0</u>	<u>20</u>
<u>Red Sand + Green Gumbo</u>	<u>20</u>	<u>80</u>
<u>Pine Gully Sand</u>	<u>80</u>	<u>140</u>
<u>Blue Clay</u>	<u>140</u>	<u>325</u>
<u>Good Sand</u>	<u>325</u>	<u>362</u>

WELL LOCATION:
 section 20-T-0N R. 10-E
1 miles N of Biloxi
 (distance) (direction) (nearest town)

WELL PURPOSE: HOME
 (home, irrigation, municipal, industrial)

- WELL COMPLETION DATA:
- (1) diameter (inches) 2"
 - (2) total depth (feet) 362'
 - (3) static water level (feet) 50' ^{below}/_{above} top of ground.
 - (4) casing PVC, 352'
 (material) (depth)
2" if telescope see back.
 (size)
 - (5) screen 10', 352'
 (length) (depth to top)
2", PVC
 (size) (material)
 - (6) pump 1 15
 (HP) (yield gpm)
electric
 (type power)
 - (7) electric log No
 (yes or no)
No
 (organization running log)
 - (8) how well bottom plugged sand
shack

DEPT. OF NATURAL RESOURCES
 BUREAU OF LAND & WATER REVENUES


SEP - 5 1984

RECEIVED

DRILLERS REMARKS:

If well telescopes please sketch and show depths.

GROUND LEVEL

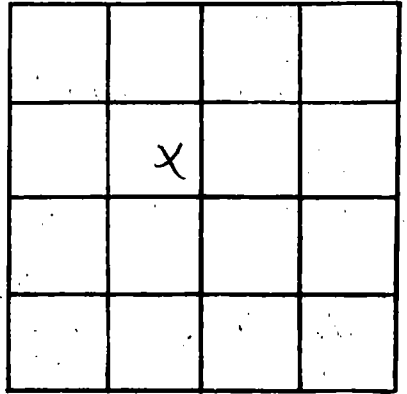

SECTION 16

Please indicate well location X.

ADDITIONAL INFORMATION

If more than one screen, show locations of each on sketch.