

MISSISSIPPI DEPARTMENT OF NATURAL RESOURCES

Bureau of Land and Water Resources

Southport Mall

P.O. Box 10631

Jackson, Mississippi 39209

WATER WELL DRILLERS LOG

COASTAL DRILLING & SERVICE CO.

Harrison  
M 2413  
6-30-84

6/30/84

date well completed

ROUTE 1 BOX 618

BILOXI, MISS. 39532

Harrison  
county well located

LANDOWNER: T. Burd

Old Hwy. 67-15

Biloxi, miss  
(mailing address)

WELL LOCATION:

sec. 10 T 7 S R 9 E W

(distance) miles (direction) of (nearest town)

WELL PURPOSE: home  
(home, irrigation, municipal, industrial)

WELL COMPLETION DATA:

- (1) diameter (inches) 2"
- (2) total depth (feet) 330
- (3) static water level (feet) 20 above below top of ground.
- (4) casing pvc 320  
(material) (depth)
- (size) if telescope see back.
- (5) screen 10' 320  
(length) (depth to top)
- 2 pvc  
(size) (material)
- (6) pump Home 12  
(HP) (yield gpm)
- etc.  
(type power)
- (7) electric log NO  
(yes or no)

(organization running log)

(8) how well bottom plugged 2" backwash valve

DRILLERS REMARKS: 19-D


description of formations encountered	from to	
top soil	1	4
red clay	4	15
sugar sand	15	210
soft blue clay	210	310
fine water sand	310	330
good water sand	330	330

RECEIVED  
JUL 22 1985

Department of Natural Resources  
Bureau of Land & Water Resources

If well telescopes please sketch and show depths.

GROUND LEVEL

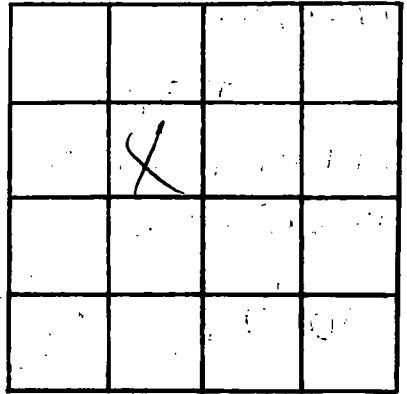

SECTION \_\_\_\_\_

Please indicate well location X.

ADDITIONAL INFORMATION

If more than one screen,  
show locations of each on sketch.