

MISSISSIPPI DEPARTMENT OF NATURAL RESOURCES

Bureau of Land and Water Resources

Southport Mall

P.O. Box 10631

Jackson, Mississippi 39209

WATER WELL DRILLERS LOG

Harrison  
M  
2415

7-20-84  
date well completed

Coast Water Well Sew  
firm name

Harrison  
county well located

LANDOWNER: Robert Hardy  
64087 Washington Ave  
Ocean Springs, Miss.  
(mailing address) 39864

description of formations encountered	from	to
Top soil	0	2'
Red Clay	2'	10'
Blue Clay	10'	33'
Red coarse sand & gravel	33'	63'
Blue Clay	63'	380'
Blue Clay & Quartz shell	380'	427'
Blue Clay	427'	728'
Gray coarse sand	728'	775'

WELL LOCATION:  
sec. 8 T 7 N R 9 E  
S W  
1/2 miles NW of D'IBERVILLE  
(distance) (direction) (nearest town)

WELL PURPOSE: Home  
(home, irrigation, municipal, industrial)

WELL COMPLETION DATA:  
(1) diameter (inches) 2"  
(2) total depth (feet) 775'  
(3) static water level (feet) 42' below top of ground.  
(4) casing PVC 775'  
(material) (depth)  
2" if telescope see back.  
(size)  
(5) screen 20' 775'  
(length) (depth to top)  
2" PVC  
(size) (material)  
(6) pump 1/2 HP 9  
(HP) (yield gpm)  
1/2 Elmer  
(type power)  
(7) electric log No  
(yes or no)  
(organization running log)

(8) How well bottom plugged?  
Back Wash Valve

DRILLERS REMARKS:


DEPT. OF NATURAL RESOURCES  
BUREAU OF LAND & WATER RESOURCES

OCT 11 1984

RECEIVED

If well telescopes please sketch and show depths.

GROUND LEVEL

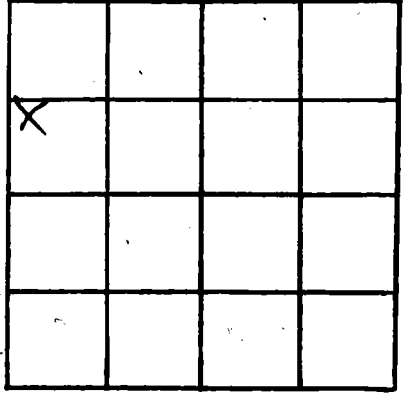

SECTION 8

Please indicate well location X.

ADDITIONAL INFORMATION

If more than one screen,  
show locations of each on sketch.