

MISSISSIPPI DEPARTMENT OF NATURAL RESOURCES

Bureau of Land and Water Resources

Southport Mall

P.O. Box 10631

Jackson, Mississippi 39209

WATER WELL DRILLERS LOG

COASTAL DRILLING & SERVICE CO.

Harrison
M 2416
7-27-84

7/27/84
date well completed

ROUTE 1 BOX 618

HARRISON
county well located

LANDOWNER: Tommy Daniels

Mill Creek Estates

Biloxi, MS
(mailing address)

WELL LOCATION:

sec. 9 T 6 N R 10 E
S W
Biloxi
(distance) (direction) (nearest town)

WELL PURPOSE: home
(home, irrigation, municipal, industrial)

WELL COMPLETION DATA:

- (1) diameter (inches) 4 1/2"
- (2) total depth (feet) 440
- (3) static water level (feet) 425 below top of ground.
- (4) casing pvc, 425,
(material) (depth)
4 1/2" if telescope see back.
(size)
- (5) screen 1 1/2', 425
(length) (depth to top)
2", pvc
(size) (material)
- (6) pump L, 2710
(HP) (yield gpm)
ELC
(type power)
- (7) electric log No
(yes or no)

(organization running log)

(8) how well bottom plugged 2' back
WASH VALVE A-B

DRILLERS REMARKS:

description of formations encountered	from	to
top soil	1	3
red clay	3	20
sugar sand	20	45
course white sand	45	65
soft blue clay	65	120
hard blue clay	120	260
rock	260	350
soft blue clay	350	405
silt water sand	405	415
good water sand	415	425

RECEIVED

JUL 22 1985

Department of Natural Resources
Bureau of Land & Water Resources

If well telescopes please sketch and show depths.


GROUND LEVEL

200 4" PVC CASING

240 2" PVC CASING

15' 2" PVC SCREEN

2" BACK WASH VALVE

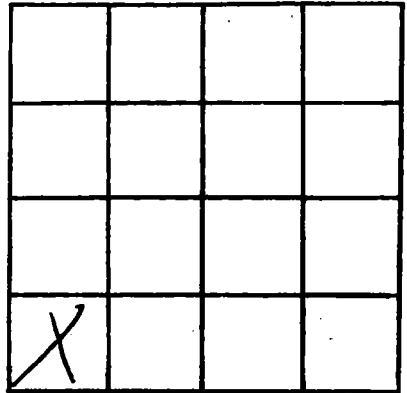

SECTION _____

Please indicate well location X.

ADDITIONAL INFORMATION

If more than one screen, show locations of each on sketch.