

MISSISSIPPI DEPARTMENT OF NATURAL RESOURCES

Bureau of Land and Water Resources

Southport Mall

P.O. Box 10631

Jackson, Mississippi 39209

WATER WELL DRILLERS LOG
 COASTAL DRILLING & SERVICE CO.

Harrison
M 2417
7-27-84

7/27/84
 date well completed

RT. 11, BOX 81
 firm name

Harrison
 county well located

BILOXI, MS 39532


LANDOWNER: Jim Prohmel

description of formations encountered	from	to
	top soil	1
red clay	3	20
zeug sand	20	30
horizontal clay	30	80
good water sand	80	90

Hwy 67

Saucier, ms
 (mailing address)

WELL LOCATION:

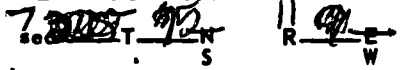

5 saucier miles (distance) NE (direction) of (nearest town)

WELL PURPOSE: home
 (home, irrigation, municipal, industrial)

WELL COMPLETION DATA:

- (1) diameter (inches) 2"
- (2) total depth (feet) 90'
- (3) static water level (feet) 10' below above top of ground.
- (4) casing PVC, 80'
 (material) (depth)

(size) if telescope see back.

- (5) screen 10', 80'
 (length) (depth to top)
- 2", PVC
 (size) (material)

- (6) pump 1, 711
 (HP) (yield gpm)

ELC
 (type power)

- (7) electric log No
 (yes or no)

(organization running log)

- (8) how well bottom plugged 2' back wash water 198

DRILLERS REMARKS: None

RECEIVED
 JUL 22 1985

Department of Natural Resources
 Bureau of Land & Water Resources

If well telescopes please sketch and show depths.

GROUND LEVEL

	X		

SECTION _____
Please indicate well location X.

ADDITIONAL INFORMATION

If more than one screen, show locations of each on sketch.