

MISSISSIPPI DEPARTMENT OF NATURAL RESOURCES

Bureau of Land and Water Resources

Southport Mall

P.O. Box 10631

Jackson, Mississippi 39209

WATER WELL DRILLERS LOG

COASTAL DRILLING & SERVICE CO.

HARRISON
M 2418

8/20/84
date well completed

RT. 11, BOX 81
firm name

BILOXI, MS 39532

Harrison
county well located

LANDOWNER: C.D. Jenkins

Campbell Rd

Biloxi, MS
(mailing address)

WELL LOCATION:
sec. 27 7 N R 9 E
S W
Biloxi miles of
(distance) (direction) (nearest town)

WELL PURPOSE: home
(home, irrigation, municipal, industrial)

WELL COMPLETION DATA:

- (1) diameter (inches) 4" x 2"
- (2) total depth (feet) 540
- (3) static water level (feet) 15 below top of ground.
- (4) casing PVC, 525, 4" x 2" if telescope see back.
(material) (depth) (size)
- (5) screen 15', 525, 2" PVC
(length) (depth to top) (size) (material)
- (6) pump 1, 1712
(HP) (yield gpm)
elc. (type power)
- (7) electric log N/A
(yes or no)

(organization running log)

(8) how well bottom plugged 2" back
wash water 19-B

DRILLERS REMARKS:

description of formations encountered	from	to
top	6	10
behan sand	17	30
red clay	30	180
fine water sand	180	200
light blue clay	200	310
coarse white sand	310	330
hard blue clay	330	520
fine water sand	520	530
good water sand	530	540

RECEIVED
AUG - 5 1985

Department of Natural Resources
Bureau of Land & Water Resources

If well telescopes please sketch and show depths.


GROUND LEVEL

160' 4" pvc casing

350' 2" pvc casing

15' 2" pvc screen

2" back wash valve

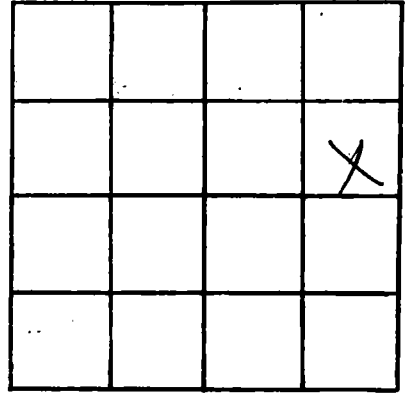

SECTION _____

Please indicate well location X.

ADDITIONAL INFORMATION

If more than one screen, show locations of each on sketch.