

MISSISSIPPI DEPARTMENT OF NATURAL RESOURCES

Bureau of Land and Water Resources

Southport Mall

P.O. Box 10631

Jackson, Mississippi 39209

WATER WELL DRILLERS LOG

*Harrison*

*Harrison*  
M  
2420

9-11-84  
date well completed

M&Gill Well Works  
firm name

~~Madison~~ Harrison  
county well located

LANDOWNER: *Larry Taber*  
*Daisy Vestor Rd.*  
*Ocean Springs, Ms.*  
(mailing address)

description of formations encountered	from	to
Sand	0	20
m' s'	20	40
mud	40	220
m' s'	220	240
mud	240	360
sand	360	420

WELL LOCATION:  
sec. 7 T 7 N 10 E  
S W  
4 miles W of Bixi  
(distance) (direction) (nearest town)

WELL PURPOSE: *Home*  
(home, irrigation, municipal, industrial)

- WELL COMPLETION DATA:
- (1) diameter (inches) 3"
  - (2) total depth (feet) 420'
  - (3) static water level (feet) 30 <sup>below</sup> above top of ground.
  - (4) casing sch 40 3" 410'  
(material) (depth)  
— if telescope see back.  
(size)
  - (5) screen 10' 410'  
(length) (depth to top)  
3" sch 40 6 slot  
(size) (material)
  - (6) pump 1 11  
(HP) (yield gpm)  
elec  
(type power)
  - (7) electric log —  
(yes or no)  
—  
(organization running log)
  - (8) how well bottom plugged Seal


DRILLERS REMARKS:

DEPT. OF NATURAL RESOURCES  
BUREAU OF LAND & WATER RESOURCES

DEC - 3 1984  
RECEIVED

If well telescopes please sketch and show depths.

GROUND LEVEL

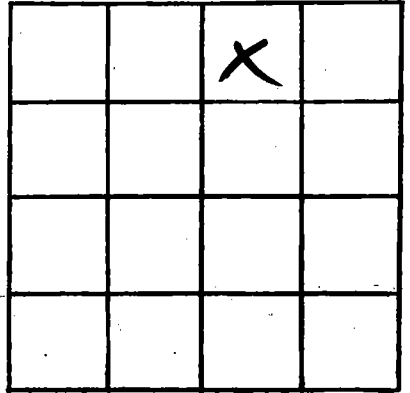

SECTION \_\_\_\_\_

Please indicate well location X.

ADDITIONAL INFORMATION

If more than one screen,  
show locations of each on sketch.