

MISSISSIPPI DEPARTMENT OF NATURAL RESOURCES

Bureau of Land and Water Resources

Southport Mall

P.O. Box 10631

Jackson, Mississippi 39209

WATER WELL DRILLERS LOG

COASTAL DRILLING & SERVICE CO.

Harrison  
M  
2422

Sept. 28, 1984  
 date well completed

RT. 11, BOX 01  
 firm name

Harrison  
 county well located

Biloxi, MS 39532

LANDOWNER: M. Adams  
201 Cedar Rd  
Biloxi, MS  
 (mailing address)

WELL LOCATION:  
 sec 26 T 7 N R 9 E  
 S W  
Biloxi miles of (distance) (direction) (nearest town)

WELL PURPOSE: home  
 (home, irrigation, municipal, industrial)

WELL COMPLETION DATA:

(1) diameter (inches) 4" x 2"

(2) total depth (feet) 480

(3) static water level (feet) 15 below top of ground.

(4) casing PVC 465  
 (material) (depth)

4" x 2"  
 (size) if telescope see back.

(5) screen 15 465  
 (length) (depth to top)

2" PVC  
 (size) (material)

(6) pump 1 9  
 (HP) (yield gpm)


ELC  
 (type power)

(7) electric log No  
 (yes or no)

(organization running log)

(8) how well bottom plugged 2" back  
washed 19-B

description of formations encountered	from	to
top soil	1	10
sugar sand	10	23
soft blue clay	23	153
fine water sand	153	180
hard blue clay	180	250
fine water sand	250	280
hard clay	280	390
hard blue clay	390	460
good water sand	460	470
fine water sand	470	480

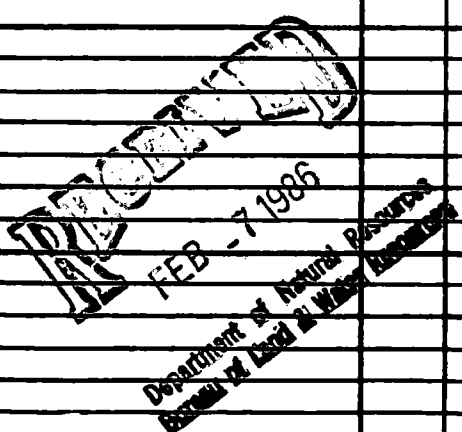

DRILLERS REMARKS:

If well telescopes please sketch and show depths.


GROUND LEVEL

240' 4" pvc casing

240' 2" pvc casing

15' pvc screen

2" back wash valve

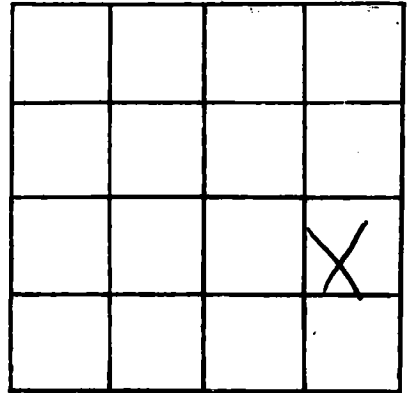

SECTION \_\_\_\_\_

Please indicate well location X.

ADDITIONAL INFORMATION

If more than one screen, show locations of each on sketch.