

MISSISSIPPI DEPARTMENT OF NATURAL RESOURCES

Bureau of Land and Water Resources

Southport Mall

P.O. Box 10631

Jackson, Mississippi 39209

WATER WELL DRILLERS LOG

COASTAL DRILLING & SERVICE CO.

Harrison  
M  
2425

Nov. 6, 1985  
 date well completed

RI. 19  
 county well located

Harrison  
 county well located

LANDOWNER: Rick Rodgers  
14951 Beach  
Biloxi, MS  
 (mailing address)

WELL LOCATION:  
 sec. 27 T. 7 N. R. 19 E. S. W  
Biloxi (distance) (direction) (nearest town)

WELL PURPOSE: home  
 (home, irrigation, municipal, industrial)

WELL COMPLETION DATA:

(1) diameter (inches) 2"

(2) total depth (feet) 630'

(3) static water level (feet) 10 below top of ground.

(4) casing pvc, 620,  
 (material) (depth)  
 (size) if telescope see back.

(5) screen 10', 620  
 (length) (depth to top)  
2", pvc  
 (size) (material)

(6) pump 1, 178  
 (HP) (yield gpm)  
ELC  
 (type power)

(7) electric log No  
 (yes or no)  
 (organization running log)

(8) how well bottom plugged 2" back wash valve, 19-B

description of formations encountered	from	to
top soil	1	5
subsand	5	20
red clay	20	160
soft blue clay	160	285
coarse white sand	285	300
hard blue clay	300	420
fine water sand	420	450
hard blue clay	450	580
coarse white sand	580	610
fine water sand	610	620
good water sand	620	630


DRILLERS REMARKS:

**RECEIVED**  
 FEB 14 1986

Department of Natural Resources  
 Bureau of Land & Water Resources

If well telescopes please sketch and show depths.

GROUND LEVEL

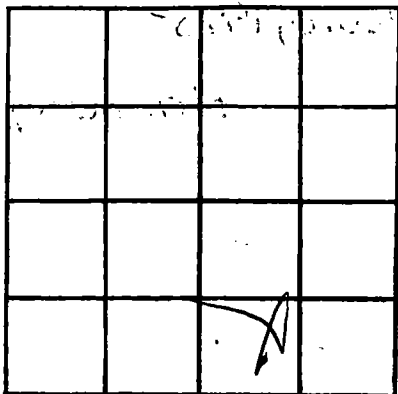

SECTION \_\_\_\_\_

Please indicate well location X.

ADDITIONAL INFORMATION

If more than one screen, show locations of each on sketch.