

MISSISSIPPI DEPARTMENT OF NATURAL RESOURCES

Bureau of Land and Water Resources

Southport Mall

P.O. Box 10631

Jackson, Mississippi 39209

WATER WELL DRILLERS LOG

CENTRAL DRILLING & SERVICE CO.

JACKSON
M
2426

Nov 16, 1984
 date well completed

RT. 11 BOX 81
 RT. name

JACKSON
 county well located

LANDOWNER: Frank McInnis

description of formations encountered

from to

1985 Dells Rd

top ~~blue~~ soil

1 10

Biloxi, MS

separ sand

10 30

(mailing address)

red clay

30 140

WELL LOCATION:

best blue clay

140 260

sec. 27 T 2 N R 19 E

coarse white sand

260 390

Biloxi miles

hard blue clay

390 480

(distance) (direction) (nearest town)

fine water sand

480 490

WELL PURPOSE: home
 (home, irrigation, municipal, industrial)

good water sand

490 500

WELL COMPLETION DATA:

(1) diameter (inches) 4" x 2"

(2) total depth (feet) 500

(3) static water level (feet) 15 below above top of ground.

(4) casing PVC, 485,
 (material) (depth)

4" x 2" If telescope see back.
 (size)

(5) screen 15', 485
 (length) (depth to top)

2", PVC
 (size) (material)

(6) pump 1, 16-10
 (HP) (yield gpm)

etc.
 (type power)

(7) electric log no
 (yes or no)

(organization running log)

(8) how well bottom plugged 2" back
wear name 1-9-8

DRILLERS REMARKS: None

RECEIVED
 FEB 14 1986

Department of Natural Resources
 Bureau of Land & Water Resources

If well telescopes please sketch and show depths.

GROUND LEVEL


160' 4" pvc casing

340' 2" pvc casing

15' 2" pvc screen

2" backwash valve

If more than one screen, show locations of each on sketch.

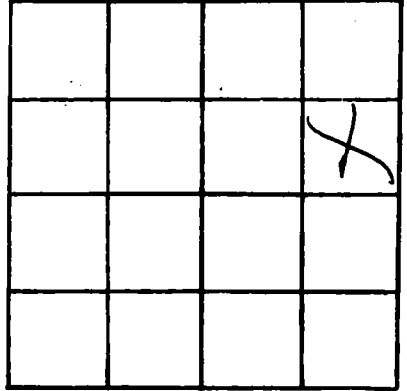

SECTION _____

Please indicate well location X.

ADDITIONAL INFORMATION

Lined area for additional information.