

MISSISSIPPI DEPARTMENT OF NATURAL RESOURCES

Bureau of Land and Water Resources

Southport Mall

P.O. Box 10631

Jackson, Mississippi 39209

WATER WELL DRILLERS LOG

CENTRAL DRILLING & SERVICE CO.

Harrison
M 2427

Nov. 8, 1984
date well completed

Rt. 11, Box 81
location

Harrison
county well located

LANDOWNER: Carl Decker
Builders
2490 Greenwood
Belle Meade
(mailing address)

description of formations encountered	from	to
top soil	1	5
bleach sand	5	20
red clay	20	160
soft blue clay	160	220
course white sand	220	250
hard blue clay	250	290
course white sand	290	340
hard blue clay	340	480
fine water sand	480	490
fine water sand	490	500

WELL LOCATION:
sec 28 T 2 N R 10 E
S W
Belle Meade miles (distance) of (direction) of (nearest town)

WELL PURPOSE:
(home, irrigation, municipal, industrial)

WELL COMPLETION DATA:

(1) diameter (inches) 2"

(2) total depth (feet) 500'

(3) static water level (feet) 10' below above top of ground.

(4) casing pvc 490'
(material) (depth)
(size) if telescope see back.


(5) screen 10' 490'
(length) (depth to top)
2" pvc
(size) (material)

(6) pump 1 18-10
(HP) (yield gpm)
plc
(type power)

(7) electric log No.
(yes or no)
(organization running log)

(8) how well bottom plugged 2' back
wash valve 19-0


DRILLERS REMARKS: None

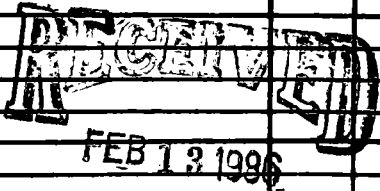

Department of Natural Resources
Bureau of Land & Water Resources

If well telescopes please sketch and show depths.

GROUND LEVEL

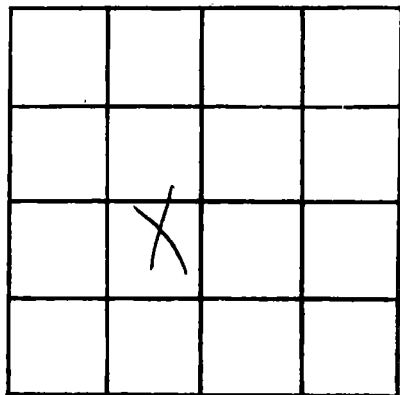

SECTION _____

Please indicate well location X.

ADDITIONAL INFORMATION

If more than one screen, show locations of each on sketch.