

MISSISSIPPI DEPARTMENT OF NATURAL RESOURCES

Bureau of Land and Water Resources

Southport Mall

P.O. Box 10631

Jackson, Mississippi 39209

COASTAL WATER WELL DRILLERS LOG
 COASTAL DRILLING & SERVICE CO.

HARRISON
 M 2436
 11/3/85

11/3/85

date well completed

RT. 11, BOX 81

firm name

Harrison
 county well located

BILOXI, MS 39532

LANDOWNER: Bill Strong

RT. 4 BOX 85

Biloxi, MS

(mailing address)

WELL LOCATION:

sec. 4 T. 6 N. R. 10 E.
 S W

1.5 miles of W of Biloxi
 (distance) (direction) (nearest town)

WELL PURPOSE: home
 (home, irrigation, municipal, industrial)

WELL COMPLETION DATA:

- (1) diameter (inches) 2"
- (2) total depth (feet) 375
- (3) static water level (feet) 10 below above top of ground.
- (4) casing PVC, 365,
 (material) (depth)
 if telescope see back.
 (size)
- (5) screen 10', 365
 (length) (depth to top)
2", PVC
 (size) (material)
- (6) pump 1 9
 (HP) (yield gpm)
ELC.
 (type power)
- (7) electric log NO
 (yes or no)

(organization running log)

(8) how well bottom plugged 2" back washwater

DRILLERS REMARKS: 10-8


description of formations encountered	from	to
top soil	1	5
ocean sand	5	25
red clay	25	195
blue clay	195	355
fresh water sand	355	365
good water sand	365	375

RECEIVED
 AUG 27 1985

Department of Natural Resources
 Bureau of Land & Water Resources

If well telescopes please sketch and show depths.

GROUND LEVEL

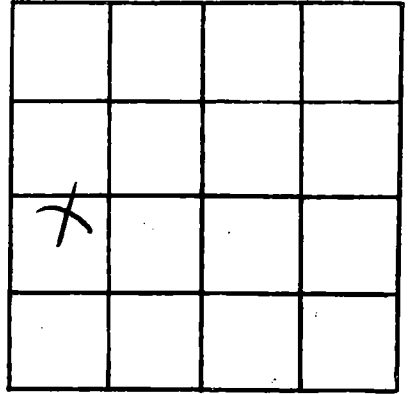

SECTION _____

Please indicate well location X.

ADDITIONAL INFORMATION

A series of horizontal lines for writing additional information.

If more than one screen, show locations of each on sketch.