

MISSISSIPPI DEPARTMENT OF NATURAL RESOURCES

Harrison?  
M 2939  
2-14-85

~~HARRISON~~ Bureau of Land and Water Resources  
Southport Mall  
P.O. Box 10631

Jackson, Mississippi 39209

WATER WELL DRILLERS LOG

COASTAL DRILLING & SERVICE CO.

2/14/85

date well completed

RI. 11, BOX 21

Harrison

county well located

LANDOWNER: Mag Woodcock

description of formations encountered

from to

1204 Shell Crest Blvd

top soil

1 5

Biloxi, MS

(mailing address)

delaysand

5 15

red clay

15 165

hard blue clay

165 260

blue water sand

260 270

leaky water sand

270 280

WELL LOCATION:

sec. 26 T. 7 N. R. 9 E. ?

Biloxi

miles (distance) of (direction) of (nearest town)

WELL PURPOSE: home

(home, irrigation, municipal, industrial)

WELL COMPLETION DATA:

(1) diameter (inches) 4" x 2"

(2) total depth (feet) 280

(3) static water level (feet) 15 below above top of ground.

(4) casing pvc, 265 (material) (depth)

4" x 2" (size) if telescope see back.

(5) screen 15, 265 (length) (depth to top)

2" (size), pvc (material)

(6) pump 1, 9 (HP) (yield gpm)

Etc. (type power)

(7) electric log No (yes or no)

(organization running log)

(8) how well bottom plugged 2" back  
woodcock 19-B

DRILLERS REMARKS:

RECEIVED  
JUL 25 1985

Department of Natural Resources  
Bureau of Land & Water Resources

If well telescopes please sketch and show depths.


GROUND LEVEL

140' 4" pvc casing

140' 2" pvc casing

15' 2" pvc screen

2" ~~in~~ back wash valve

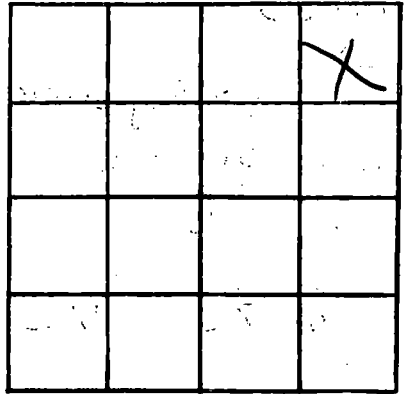

SECTION \_\_\_\_\_

Please indicate well location X.

ADDITIONAL INFORMATION

If more than one screen, show locations of each on sketch.