

MISSISSIPPI DEPARTMENT OF NATURAL RESOURCES

Bureau of Land and Water Resources

Southport Mall

P.O. Box 10631

Jackson, Mississippi 39209

COASTAL WATER WELL DRILLERS LOG

Harrison?  
M 2440  
2-15-85

2/15/85  
date well completed

RT. 11, BOX 81

BILOXI, MS <sup>firm name</sup> 39537

HARRISON


county well located

LANDOWNER: Jay and Homes

Lot 7 + 3 dot 1

BiLOXI, MS  
(mailing address)

WELL LOCATION:

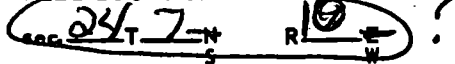

BiLOXI miles of  
(distance) (direction) (nearest town)

WELL PURPOSE: HOME  
(home, irrigation, municipal, industrial)

WELL COMPLETION DATA:

- (1) diameter (inches) 3 2"
- (2) total depth (feet) 300
- (3) static water level (feet) 10 below above top of ground.

- (4) casing PVC, 290,  
(material) (depth)

(size) if telescope see back.

- (5) screen 10', 290  
(length) (depth to top)

2", PVC  
(size) (material)

- (6) pump 1, 10  
(HP) (yield gpm)

F/C.  
(type power)

- (7) electric log NO  
(yes or no)

(organization running log)

- (8) how well bottom plugged 2" back  
wash valve 19-0

description of formations encountered	from	to
top soil	1	5
segar sand	5	15
red clay	15	140
soft blue clay	140	210
hard blue clay	210	280
fine water sand	280	290
lagoon water sand	290	300

DRILLERS REMARKS:


Department of Natural Resources  
Bureau of Land & Water Resources

RECEIVED

JUL 25 1985

If well telescopes please sketch and show depths.

GROUND LEVEL

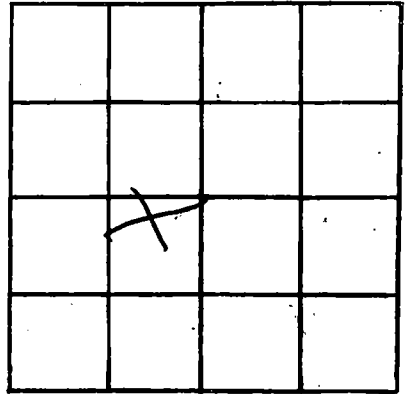

SECTION \_\_\_\_\_

Please indicate well location X.

ADDITIONAL INFORMATION

If more than one screen,  
show locations of each on sketch.